

52009



**LEGEND**

- Ø Pipe Diameter
- L Length
- HL House Connection
- IL Invert Level
- SL Surface Level
- MH Manhole
- G Grade
- USIL Up Stream Invert Level
- DSIL Down Stream Invert Level
- △ Kerb Adaptor

The as constructed assets shown hereon have been located and plotted for horizontal and vertical position only. Whilst due care and attention has been exercised, T.H Jensen Bowers Pty Ltd does not take responsibility for other attributes. These should be confirmed by the project engineer.

We T.H.Jensen Bowers Pty. Ltd., Cadastral Surveyors, hereby certify that the "As Constructed" information contained in this drawing is accurate. We accept responsibility for, and acknowledge that the "As Constructed" information may be relied on by Council and Others.

*[Signature]*  
Director

**AS CONSTRUCTED CERTIFICATION**

I, *[Signature]* hereby certify that:

1. The information contained in this drawing/document is in compliance with the approved drawings and design.
2. This represents an accurate record of as constructed works and I accept responsibility for the information in this drawing/document.

*[Signature]* RPEQ No. *11578* Date *25/11/16*  
RPEQ (signature)

DRAWING REVISIONS		REFERENCE DRAWINGS		DESIGN FILE No.	DESIGNED
REV.	REVISION DESCRIPTION	DRG. No.	DESCRIPTION	CONSTRUCT. No.	DATE
				SURVEY FILE No. S-7433-512	DRAWN MG
				FIELD BOOK	DATE 22/08/16
				LOG BOOK	CHECKED DH
				LEVEL DATUM	DATE
				DATUM	DATE


**THIS WORK WAS PREPARED BY:**  
**DEFENCE HOUSING AUSTRALIA**



**MORETON BAY REGIONAL COUNCIL**  
CABOOLTURE DISTRICT OFFICE  
2 BASKING STREET CABOOLTURE QLD 4510  
PO BOX 169 CABOOLTURE QLD 4510  
Telephone: (07) 5433 8100  
Fax: (07) 5433 4000

**WARNER SPRINGS ESTATE**  
Kremzow Road, Warner  
Stage 3  
**'AS CONSTRUCTED' - DRAINAGE**

MBRC SUBDIVISION REFERENCE	
DA/20033/2008/V4DU/11	
No. 1 OF 3 PLANS	
ASCION GRID NUMBER	REV.
52009	

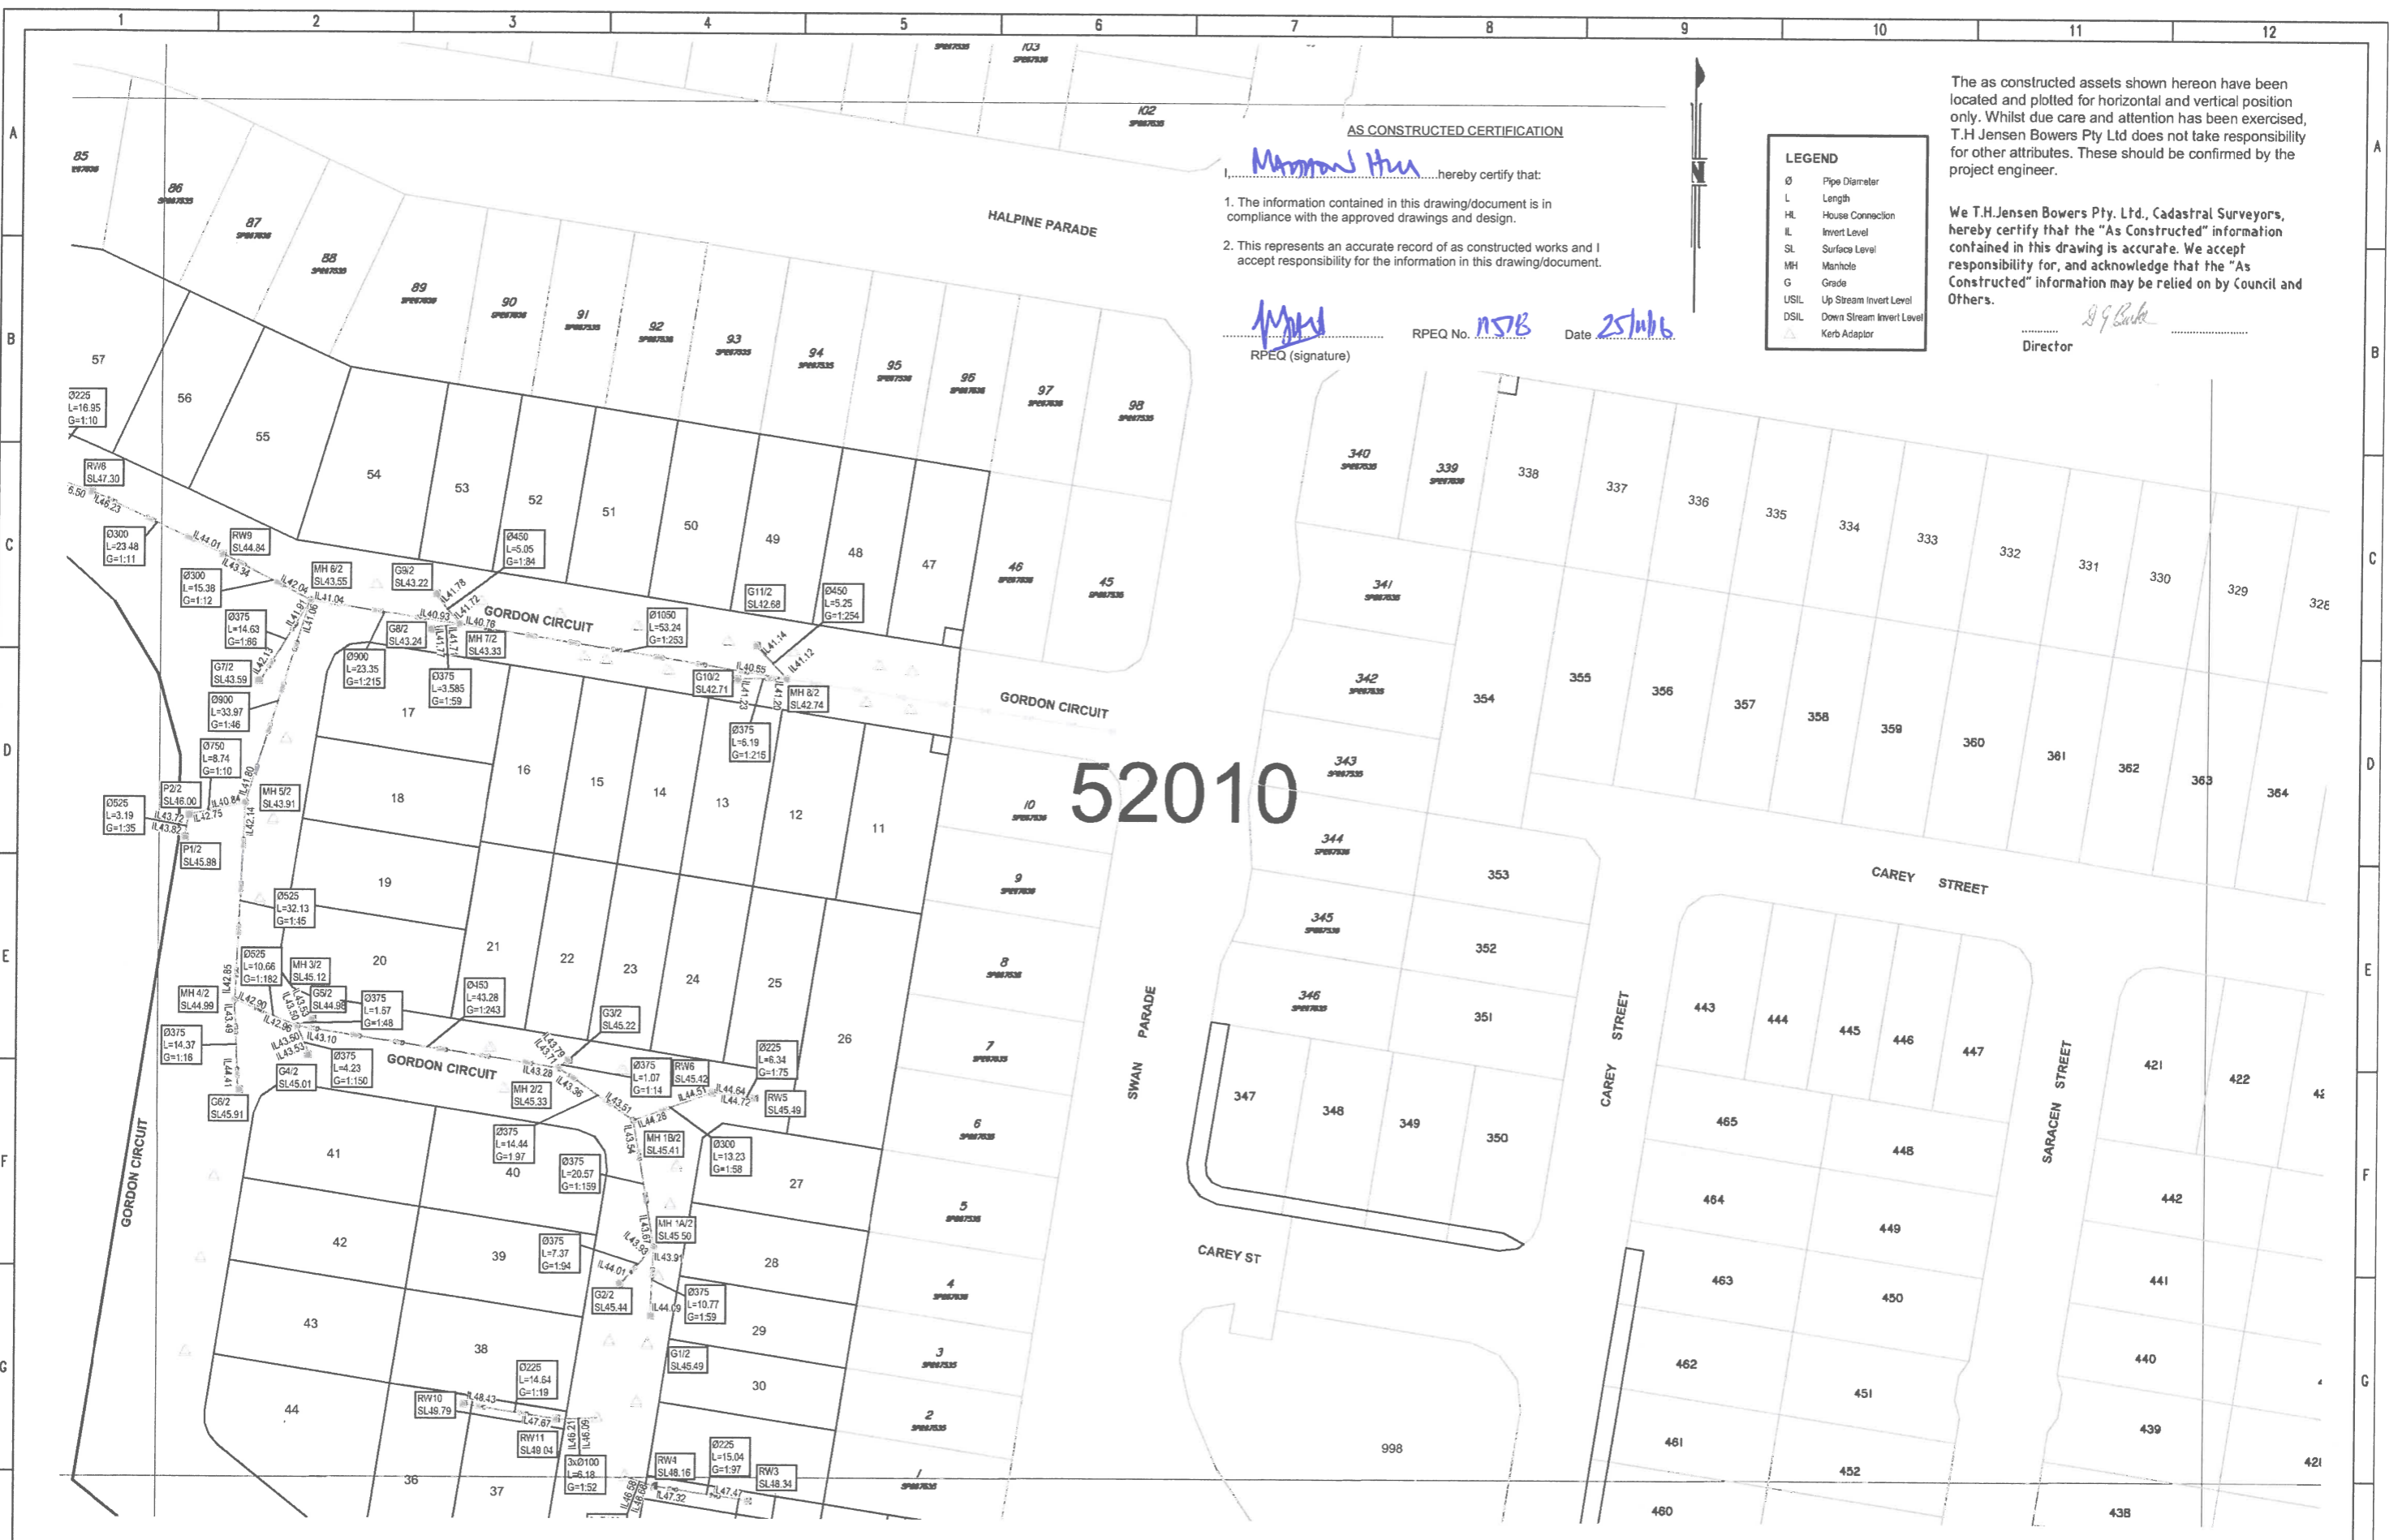

52010

AS CONSTRUCTED CERTIFICATION

I, Murray Hill hereby certify that:  
 1. The information contained in this drawing/document is in compliance with the approved drawings and design.  
 2. This represents an accurate record of as constructed works and I accept responsibility for the information in this drawing/document.

Murray Hill RPEQ No. 1578 Date 25/11/16  
 RPEQ (signature)

LEGEND


Ø	Pipe Diameter
L	Length
HL	House Connection
IL	Invert Level
SL	Surface Level
MH	Manhole
G	Gully
USIL	Up Stream Invert Level
DSIL	Down Stream Invert Level
▲	Kerb Adaptor

The as constructed assets shown hereon have been located and plotted for horizontal and vertical position only. Whilst due care and attention has been exercised, T.H Jensen Bowers Pty Ltd does not take responsibility for other attributes. These should be confirmed by the project engineer.

We T.H.Jensen Bowers Pty. Ltd., Cadastral Surveyors, hereby certify that the "As Constructed" information contained in this drawing is accurate. We accept responsibility for, and acknowledge that the "As Constructed" information may be relied on by Council and Others.

D.G. Bock  
 Director

DRAWING REVISIONS		REFERENCE DRAWINGS		DESIGN FILE No.	DESIGNED	THIS WORK WAS PREPARED BY: <b>DEFENCE HOUSING AUSTRALIA</b>	MORETON BAY REGIONAL COUNCIL CADOULTURE DISTRICT OFFICE 2 HANSHING STREET CADOULTURE QLD 4610 PO BOX 158 CADOULTURE QLD 4610 Telephone: (07) 5433 8100 Fax: (07) 5433 4000	<b>WARNER SPRINGS ESTATE</b> Kremzow Road, Warner Stage 3 'AS CONSTRUCTED' - DRAINAGE	MBRC SUBDIVISION REFERENCE		
REV.	REVISION DESCRIPTION	DRG. No.	DESCRIPTION	CONSTRUCT. No.	DATE				DA/20033/2008/V4DU/11		
				SURVEY FILE No. S-7433-512	DRAWN MG				No. 2 OF 3 PLANS		
				FIELD BOOK	DATE 22/08/16				ASCON GRID NUMBER		
				LOG BOOK	CHECKED DH				REV.		
				LEVEL DATUM	DATE	52010					
				DATUM	MGA Zone 56						
1	2	3	4	5	6	7	8	9	10	11	12

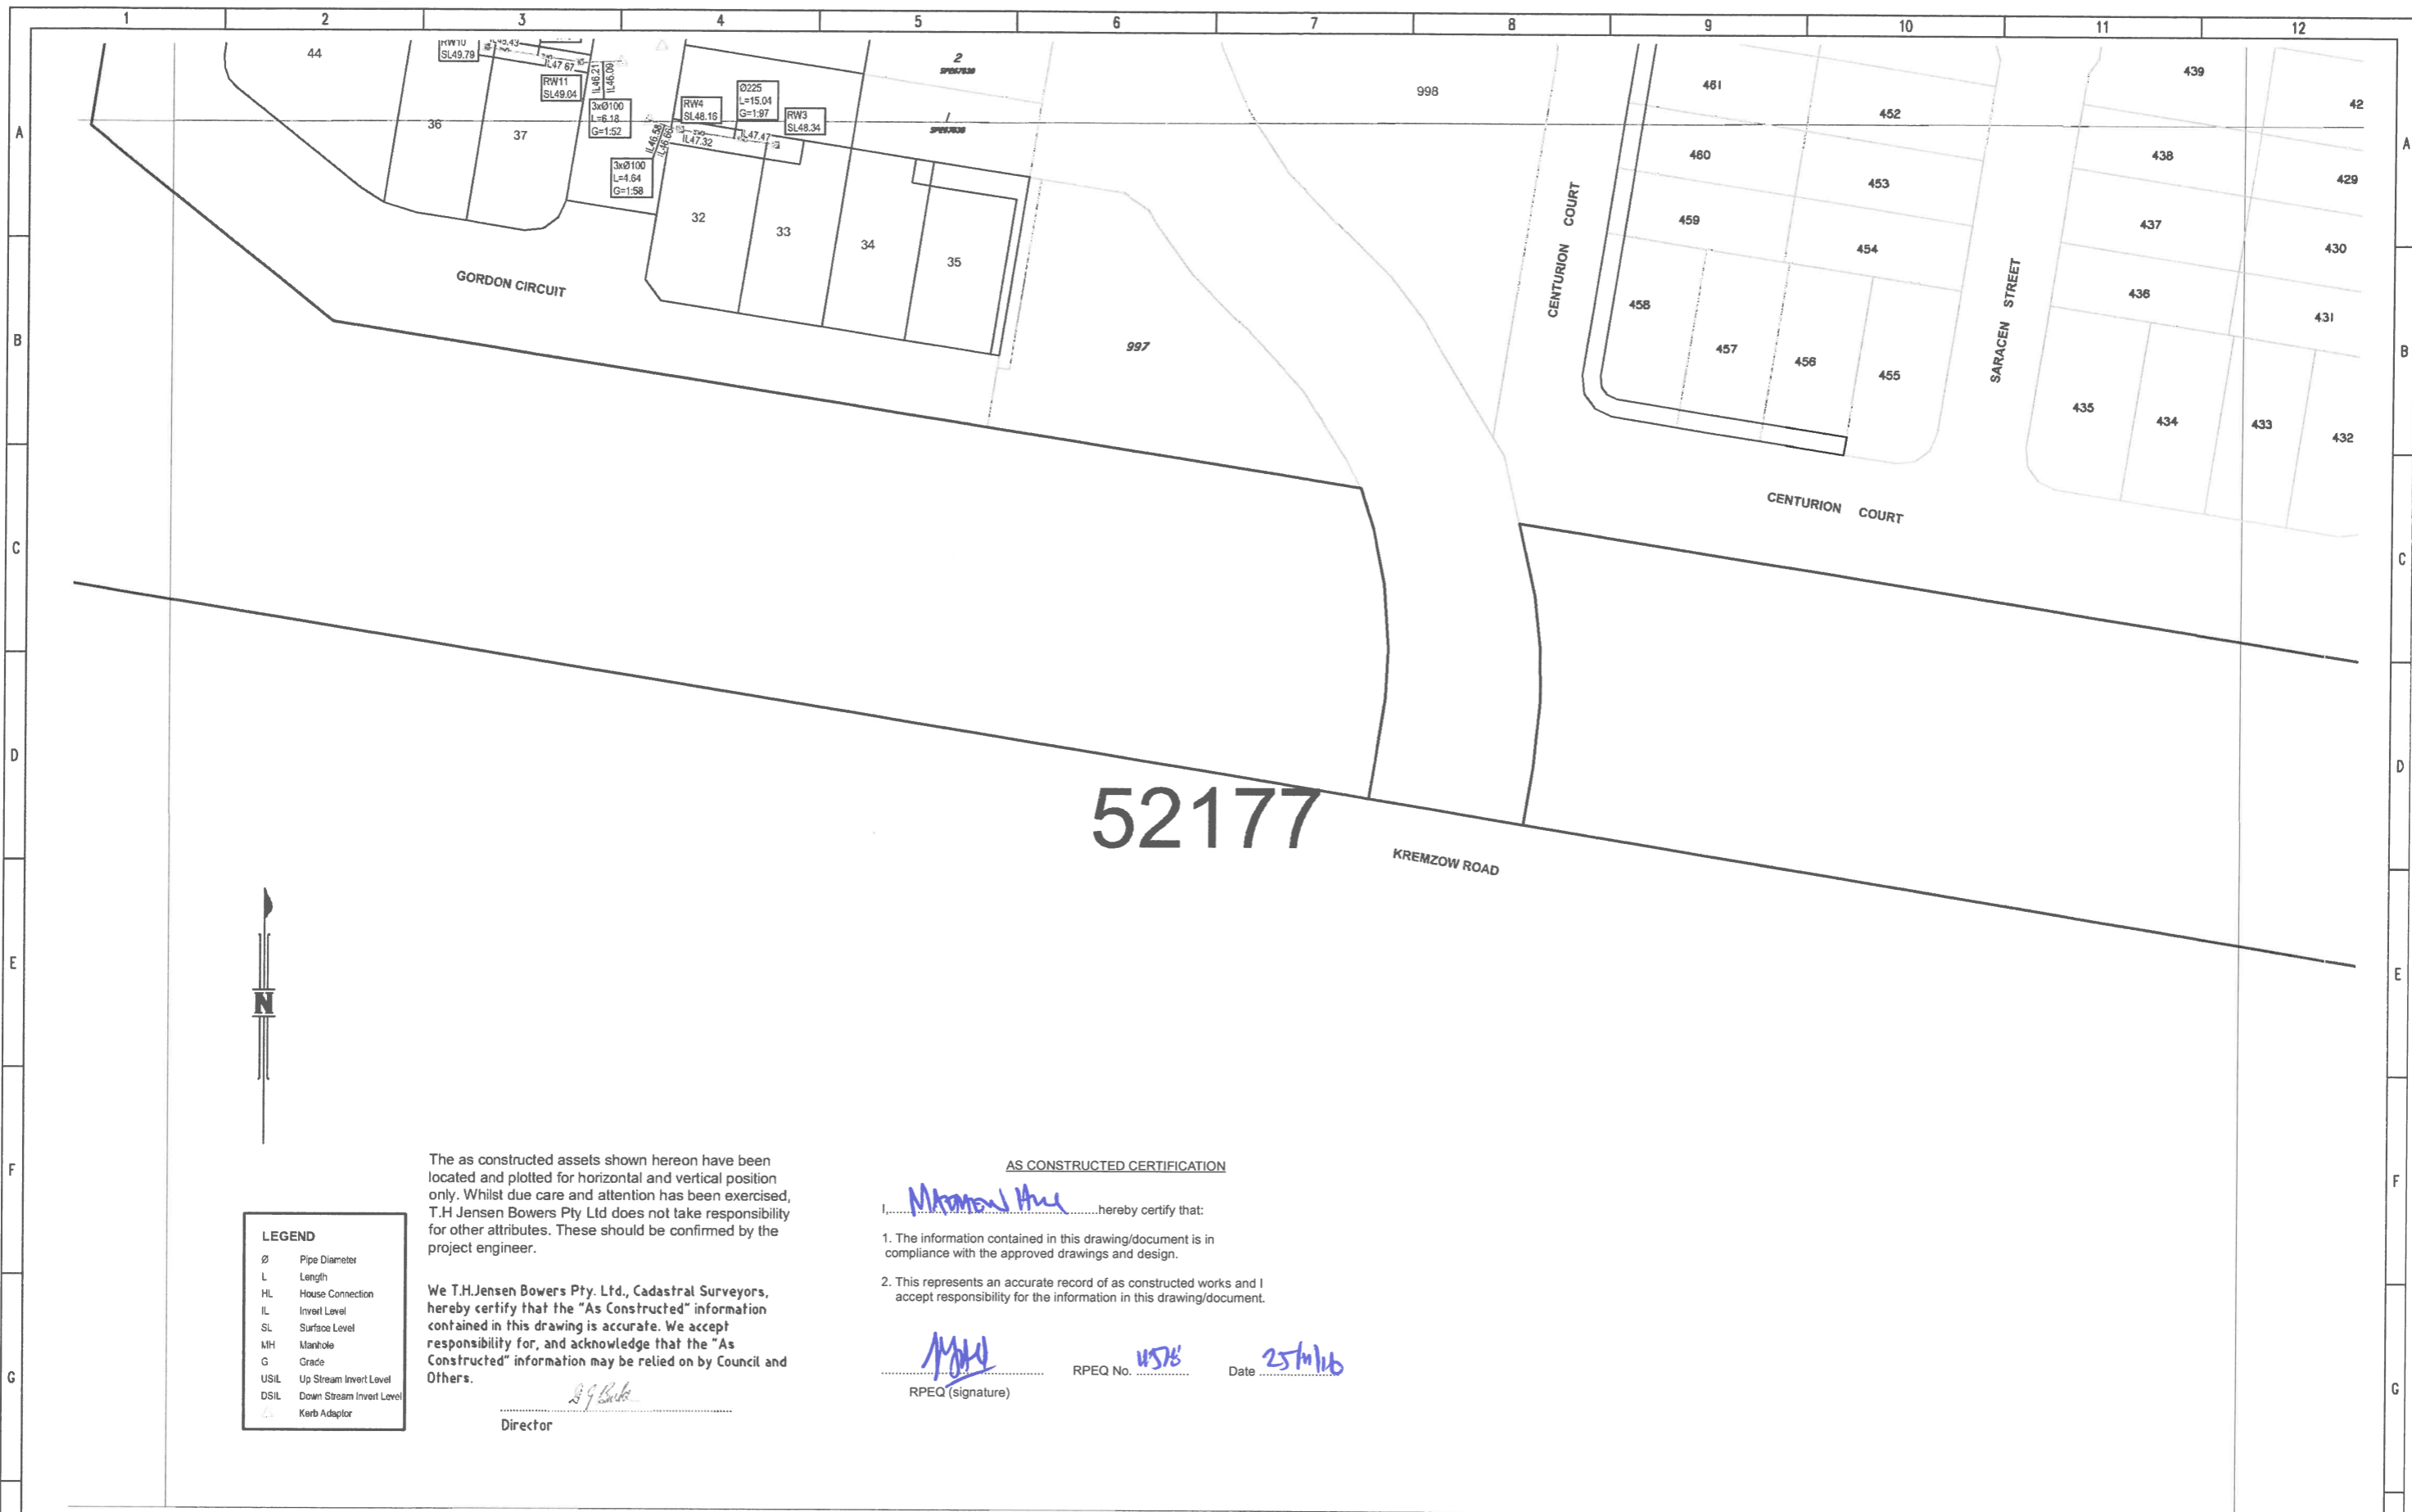

52177



**LEGEND**

∅	Pipe Diameter
L	Length
HL	House Connection
IL	Invert Level
SL	Surface Level
MH	Manhole
G	Grade
USIL	Up Stream Invert Level
DSIL	Down Stream Invert Level
△	Kerb Adaptor

The as constructed assets shown hereon have been located and plotted for horizontal and vertical position only. Whilst due care and attention has been exercised, T.H Jensen Bowers Pty Ltd does not take responsibility for other attributes. These should be confirmed by the project engineer.

We T.H.Jensen Bowers Pty. Ltd., Cadastral Surveyors, hereby certify that the "As Constructed" information contained in this drawing is accurate. We accept responsibility for, and acknowledge that the "As Constructed" information may be relied on by Council and Others.

*D. J. Bowers*  
Director

**AS CONSTRUCTED CERTIFICATION**

I, *Maxwell Hill* hereby certify that:

- The information contained in this drawing/document is in compliance with the approved drawings and design.
- This represents an accurate record of as constructed works and I accept responsibility for the information in this drawing/document.

*M Hill* RPEQ (signature) RPEQ No. *4578* Date *25/11/16*

DRAWING REVISIONS		REFERENCE DRAWINGS		DESIGN FILE No.	DESIGNED	THIS WORK WAS PREPARED BY:			<b>MORETON BAY REGIONAL COUNCIL</b> CABOOLTURE DISTRICT OFFICE 2 HASTINGS STREET CABOOLTURE QLD 4510 PO BOX 150 CABOOLTURE QLD 4510 Telephone: (07) 5433 8100 Fax: (07) 5433 4000	WARNER SPRINGS ESTATE		MBRC SUBMISSION REFERENCE DA/20033/2008/V4DU/11 No. 3 OF 3 PLANS ASCON GRID NUMBER REV. 52177
REV.	REVISION DESCRIPTION	DRG. No.	DESCRIPTION	CONSTRUCT. No.	DATE	DEFENCE HOUSING AUSTRALIA				Kremzow Road, Warner Stage 3		
				SURVEY FILE No. S-7433-512 <td>DATE <td>MG <td></td> <td></td> <td></td> <td></td> <td></td> <td></td> </td></td>	DATE <td>MG <td></td> <td></td> <td></td> <td></td> <td></td> <td></td> </td>	MG <td></td> <td></td> <td></td> <td></td> <td></td> <td></td>						
				FIELD BOOK <td>DATE <td>22/08/16 <td></td> <td></td> <td></td> <td></td> <td></td> <td></td> </td></td>	DATE <td>22/08/16 <td></td> <td></td> <td></td> <td></td> <td></td> <td></td> </td>	22/08/16 <td></td> <td></td> <td></td> <td></td> <td></td> <td></td>						
				LOG BOOK <td>CHECKED <td>DH <td></td> <td></td> <td></td> <td></td> <td></td> <td></td> </td></td>	CHECKED <td>DH <td></td> <td></td> <td></td> <td></td> <td></td> <td></td> </td>	DH <td></td> <td></td> <td></td> <td></td> <td></td> <td></td>						
				LEVEL DATUM 