



LEGEND		NOTES	
Ø	Pipe Diameter	•	All sewer mains are Ø150 uPVC Class SN8 unless otherwise stated
L	Length	•	All house connections are Ø100 uPVC Class SN10
HC	House Connection	•	All sewer lines are at a 1.5m alignment to the boundary unless otherwise stated
IL	Invert Level		
SL	Surface Level		
MH	Manhole		
G	Grade		
FSL	Finished Surface Level		

We T.H.Jensen Bowers Pty. Ltd., Cadastral Surveyors, hereby certify that the "As Constructed" information contained in this drawing is accurate. We accept responsibility for, and acknowledge that the "As Constructed" information may be relied on by Council and Others.

Director

The as constructed assets shown hereon have been located and plotted for horizontal and vertical position only. Whilst due care and attention has been exercised, T.H.Jensen Bowers Pty Ltd does not take responsibility for other attributes. These should be confirmed by the project engineer.

DRAWING REVISIONS		REFERENCE DRAWINGS		DESIGN FILE No.		DESIGNED	
REV.	REVISION DESCRIPTION	DRG. No.	DESCRIPTION	CONSTRUCT. No.	SURVEY FILE No.	DATE	SB
					S-7433-201	14/04/15	SB
						CHECKED	WG
						DATE	25/06/15


THIS WORK WAS PREPARED BY:  
**DEFENCE HOUSING AUSTRALIA**

SCALE 1:500 ORIGINAL SIZE A1

MORETON BAY REGIONAL COUNCIL  
 CABOOLTURE DISTRICT OFFICE  
 2 HASKING STREET CABOOLTURE QLD 4510  
 Telephone: (07) 5433 0100  
 Fax: (07) 5433 4000

**WARNER SPRINGS ESTATE**  
 Kremzow Road, Warner  
 Stage 5a  
 'AS CONSTRUCTED' - SEWER

MBCR SUBDIVISION REFERENCE	
DA/20033/2008/N4DU7	
No. 1 OF 2 PLANS	
ASCEN GRID NUMBER	REV.
51844	

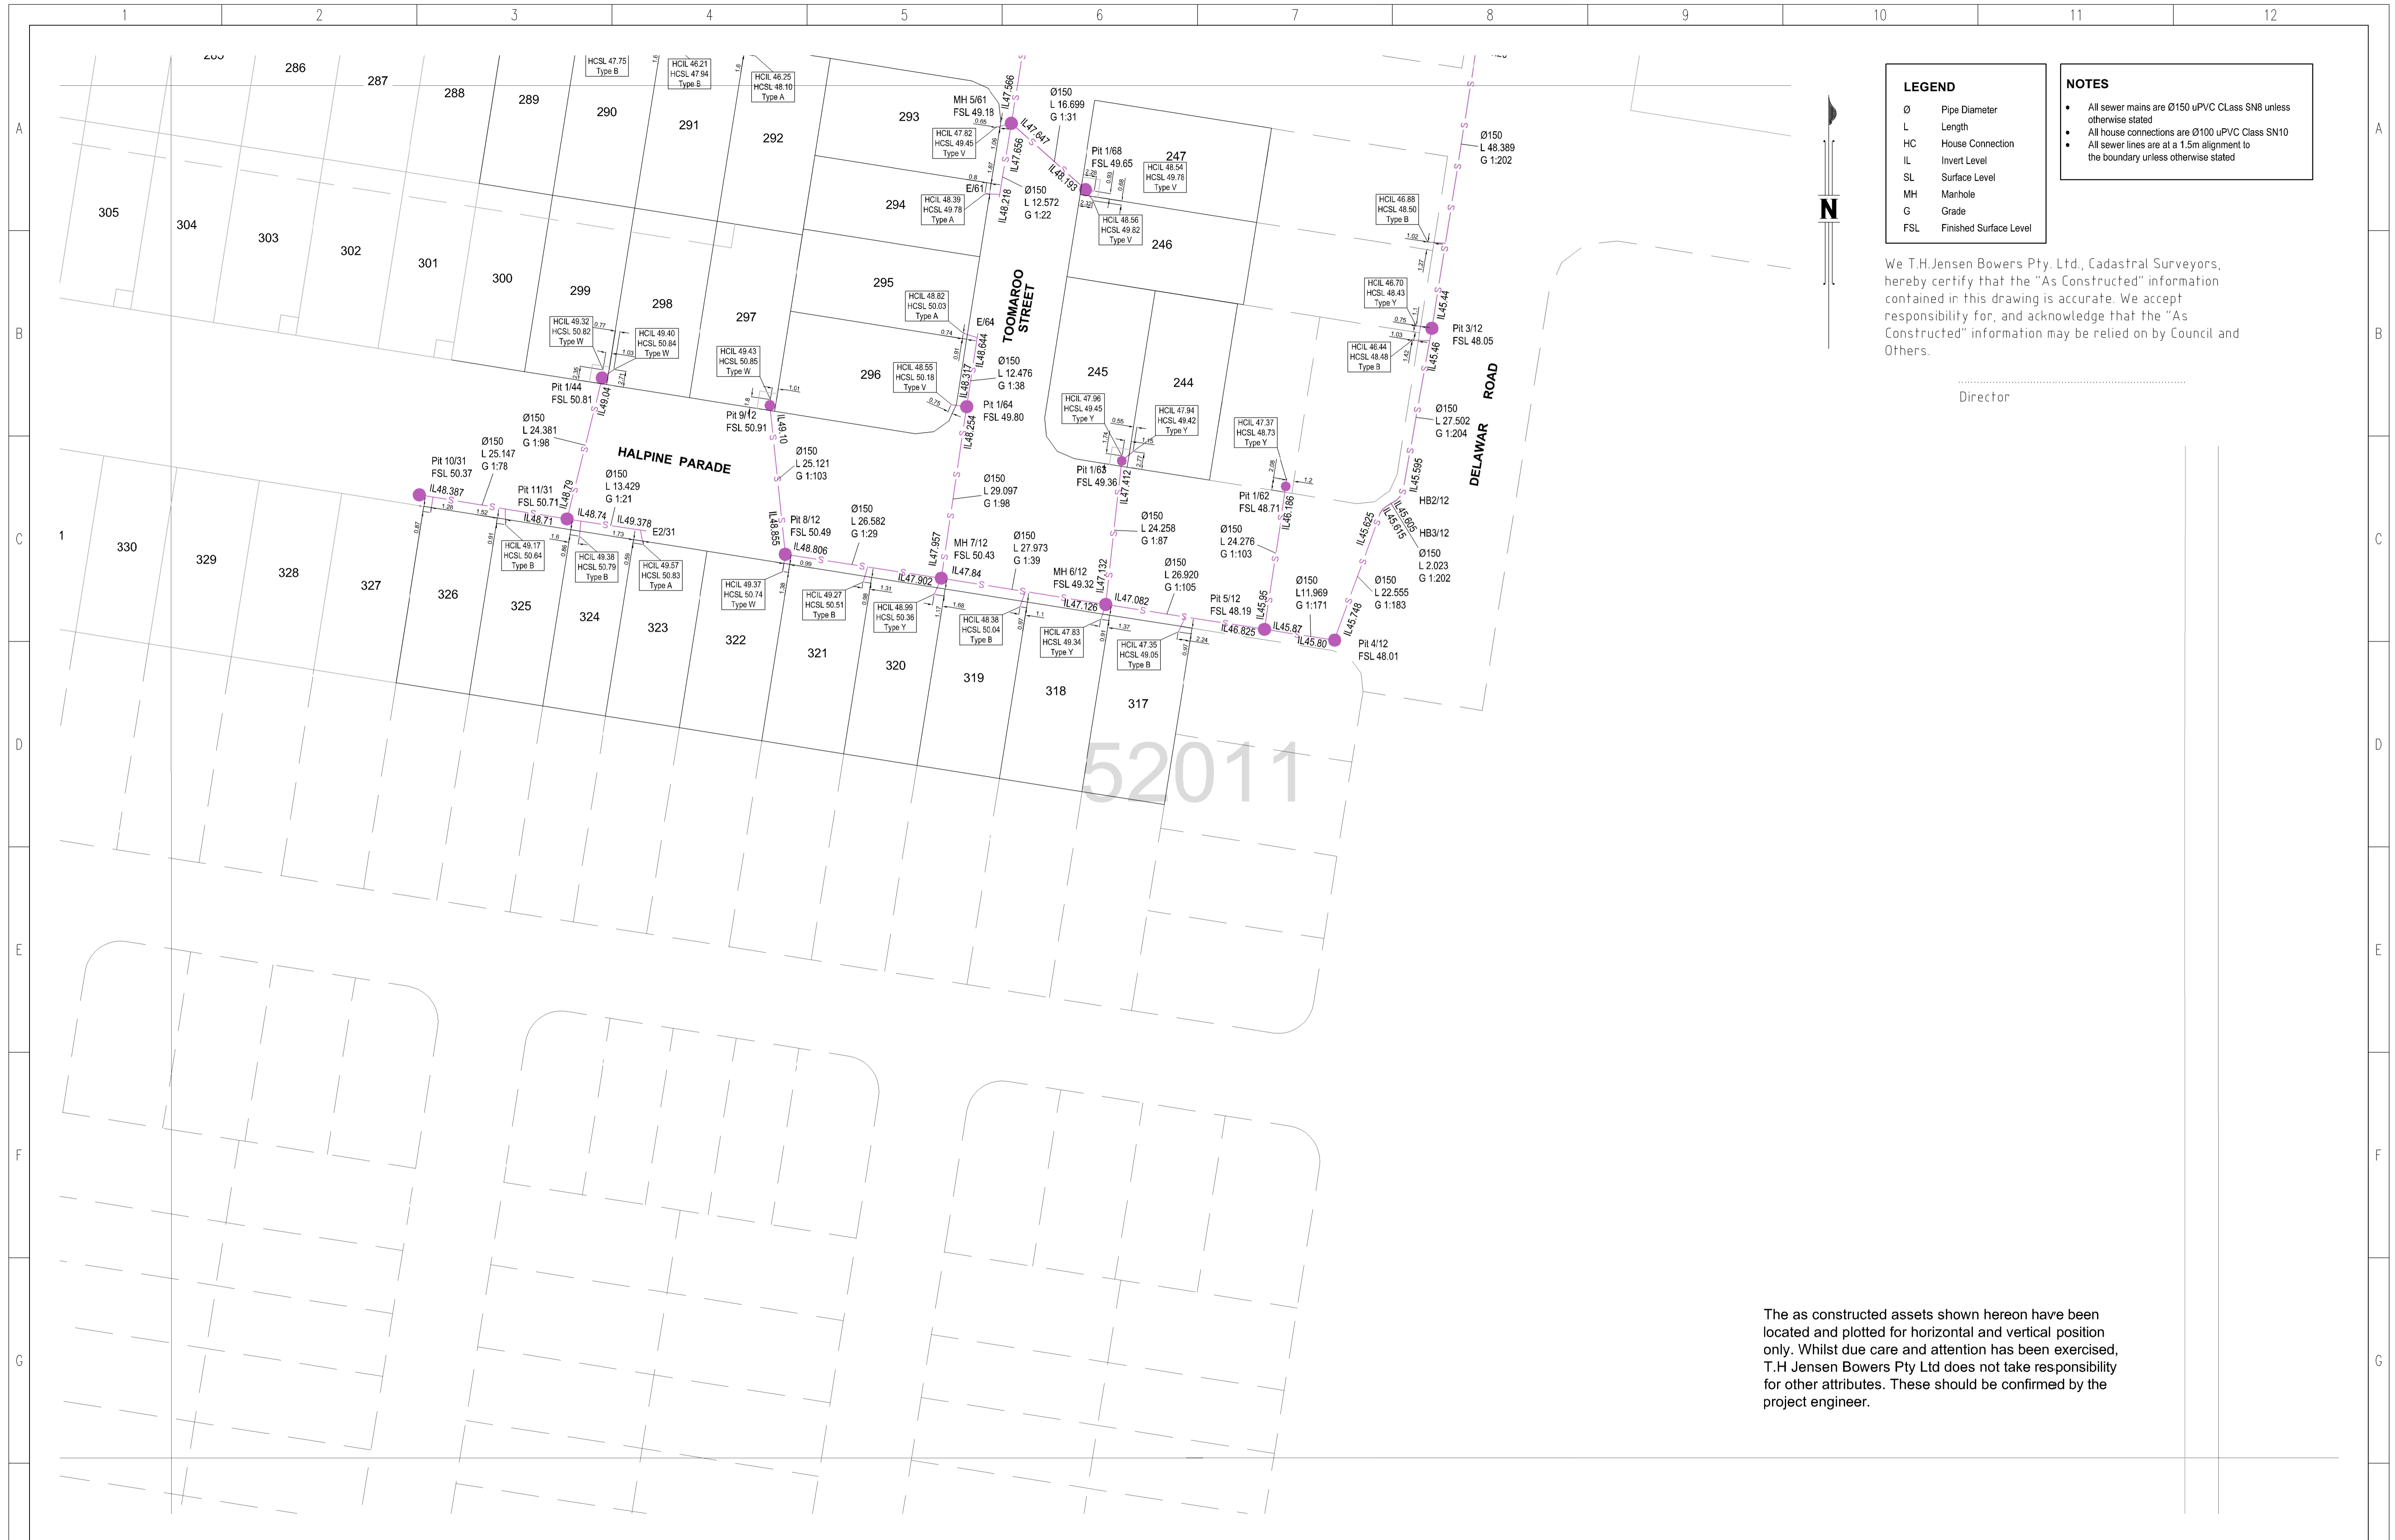

**LEGEND**

Ø	Pipe Diameter
L	Length
HC	House Connection
IL	Invert Level
SL	Surface Level
MH	Manhole
G	Grade
FSL	Finished Surface Level

- NOTES**
- All sewer mains are Ø150 uPVC Class SN8 unless otherwise stated
  - All house connections are Ø100 uPVC Class SN10
  - All sewer lines are at a 1.5m alignment to the boundary unless otherwise stated

We T.H.Jensen Bowers Pty. Ltd., Cadastral Surveyors, hereby certify that the "As Constructed" information contained in this drawing is accurate. We accept responsibility for, and acknowledge that the "As Constructed" information may be relied on by Council and Others.

Director

52011

The as constructed assets shown hereon have been located and plotted for horizontal and vertical position only. Whilst due care and attention has been exercised, T.H Jensen Bowers Pty Ltd does not take responsibility for other attributes. These should be confirmed by the project engineer.

DRAWING REVISIONS		REFERENCE DRAWINGS		DESIGN FILE No.	DESIGNED
REV.	REVISION DESCRIPTION	DRG. No.	DESCRIPTION	CONSTRUCT. No.	DATE
				SURVEY FILE No. S-7433-201	DRAWN SB
				FIELD BOOK	DATE 14/04/15
				LOG BOOK	CHECKED WG
				LEVEL DATUM PM57810 (RL47.338m)	DATE 25/06/15
				DATUM MGA Zone 56	

**THIS WORK WAS PREPARED BY:**  
**DEFENCE HOUSING AUSTRALIA**

SCALE 1:500 ORIGINAL SIZE A1



MORETON BAY REGIONAL COUNCIL  
 CABOOLTURE DISTRICT OFFICE  
 2 HASKING STREET CABOOLTURE QLD 4510  
 PO BOX 159 CABOOLTURE QLD 4510  
 Telephone: (07) 5433 0100  
 Fax: (07) 5433 4000

**WARNER SPRINGS ESTATE**  
 Kremzow Road, Warner  
 Stage 5a  
 'AS CONSTRUCTED' - SEWER

MBC SUBDIVISION REFERENCE	
DA/20033/2008/N4DU/7	
No. 2 OF 2 PLANS	
ASCAN GRID NUMBER	REV.
52011	