

LEGEND

Ø	Pipe Diameter
L	Length
HC	House Connection
IL	Invert Level
SL	Surface Level
MH	Manhole
G	Grade
FSL	Finished Surface Level

- NOTES**
- All sewer mains are Ø150 uPVC Class SN8 unless otherwise stated.
 - All house connections are Ø100 uPVC Class SN10
 - All sewer lines are at a 1.5m alignment to the boundary unless otherwise stated

We T.H.Jensen Bowers Pty. Ltd., Cadastral Surveyors, hereby certify that the "As Constructed" information contained in this drawing is accurate. We accept responsibility for, and acknowledge that the "As Constructed" information may be relied on by Council and Others.

[Signature]
Director


The as constructed assets shown hereon have been located and plotted for horizontal and vertical position only. Whilst due care and attention has been exercised, T.H.Jensen Bowers Pty Ltd does not take responsibility for other attributes. These should be confirmed by the project engineer.

AS CONSTRUCTED CERTIFICATION

I, *[Signature]* hereby certify that:

- The information contained in this drawing/document is in compliance with the approved drawings and design.
- This represents an accurate record of as constructed works and I accept responsibility for the information in this drawing/document.

[Signature] RPEQ (signature) RPEQ No. 11578 Date 22/11/16

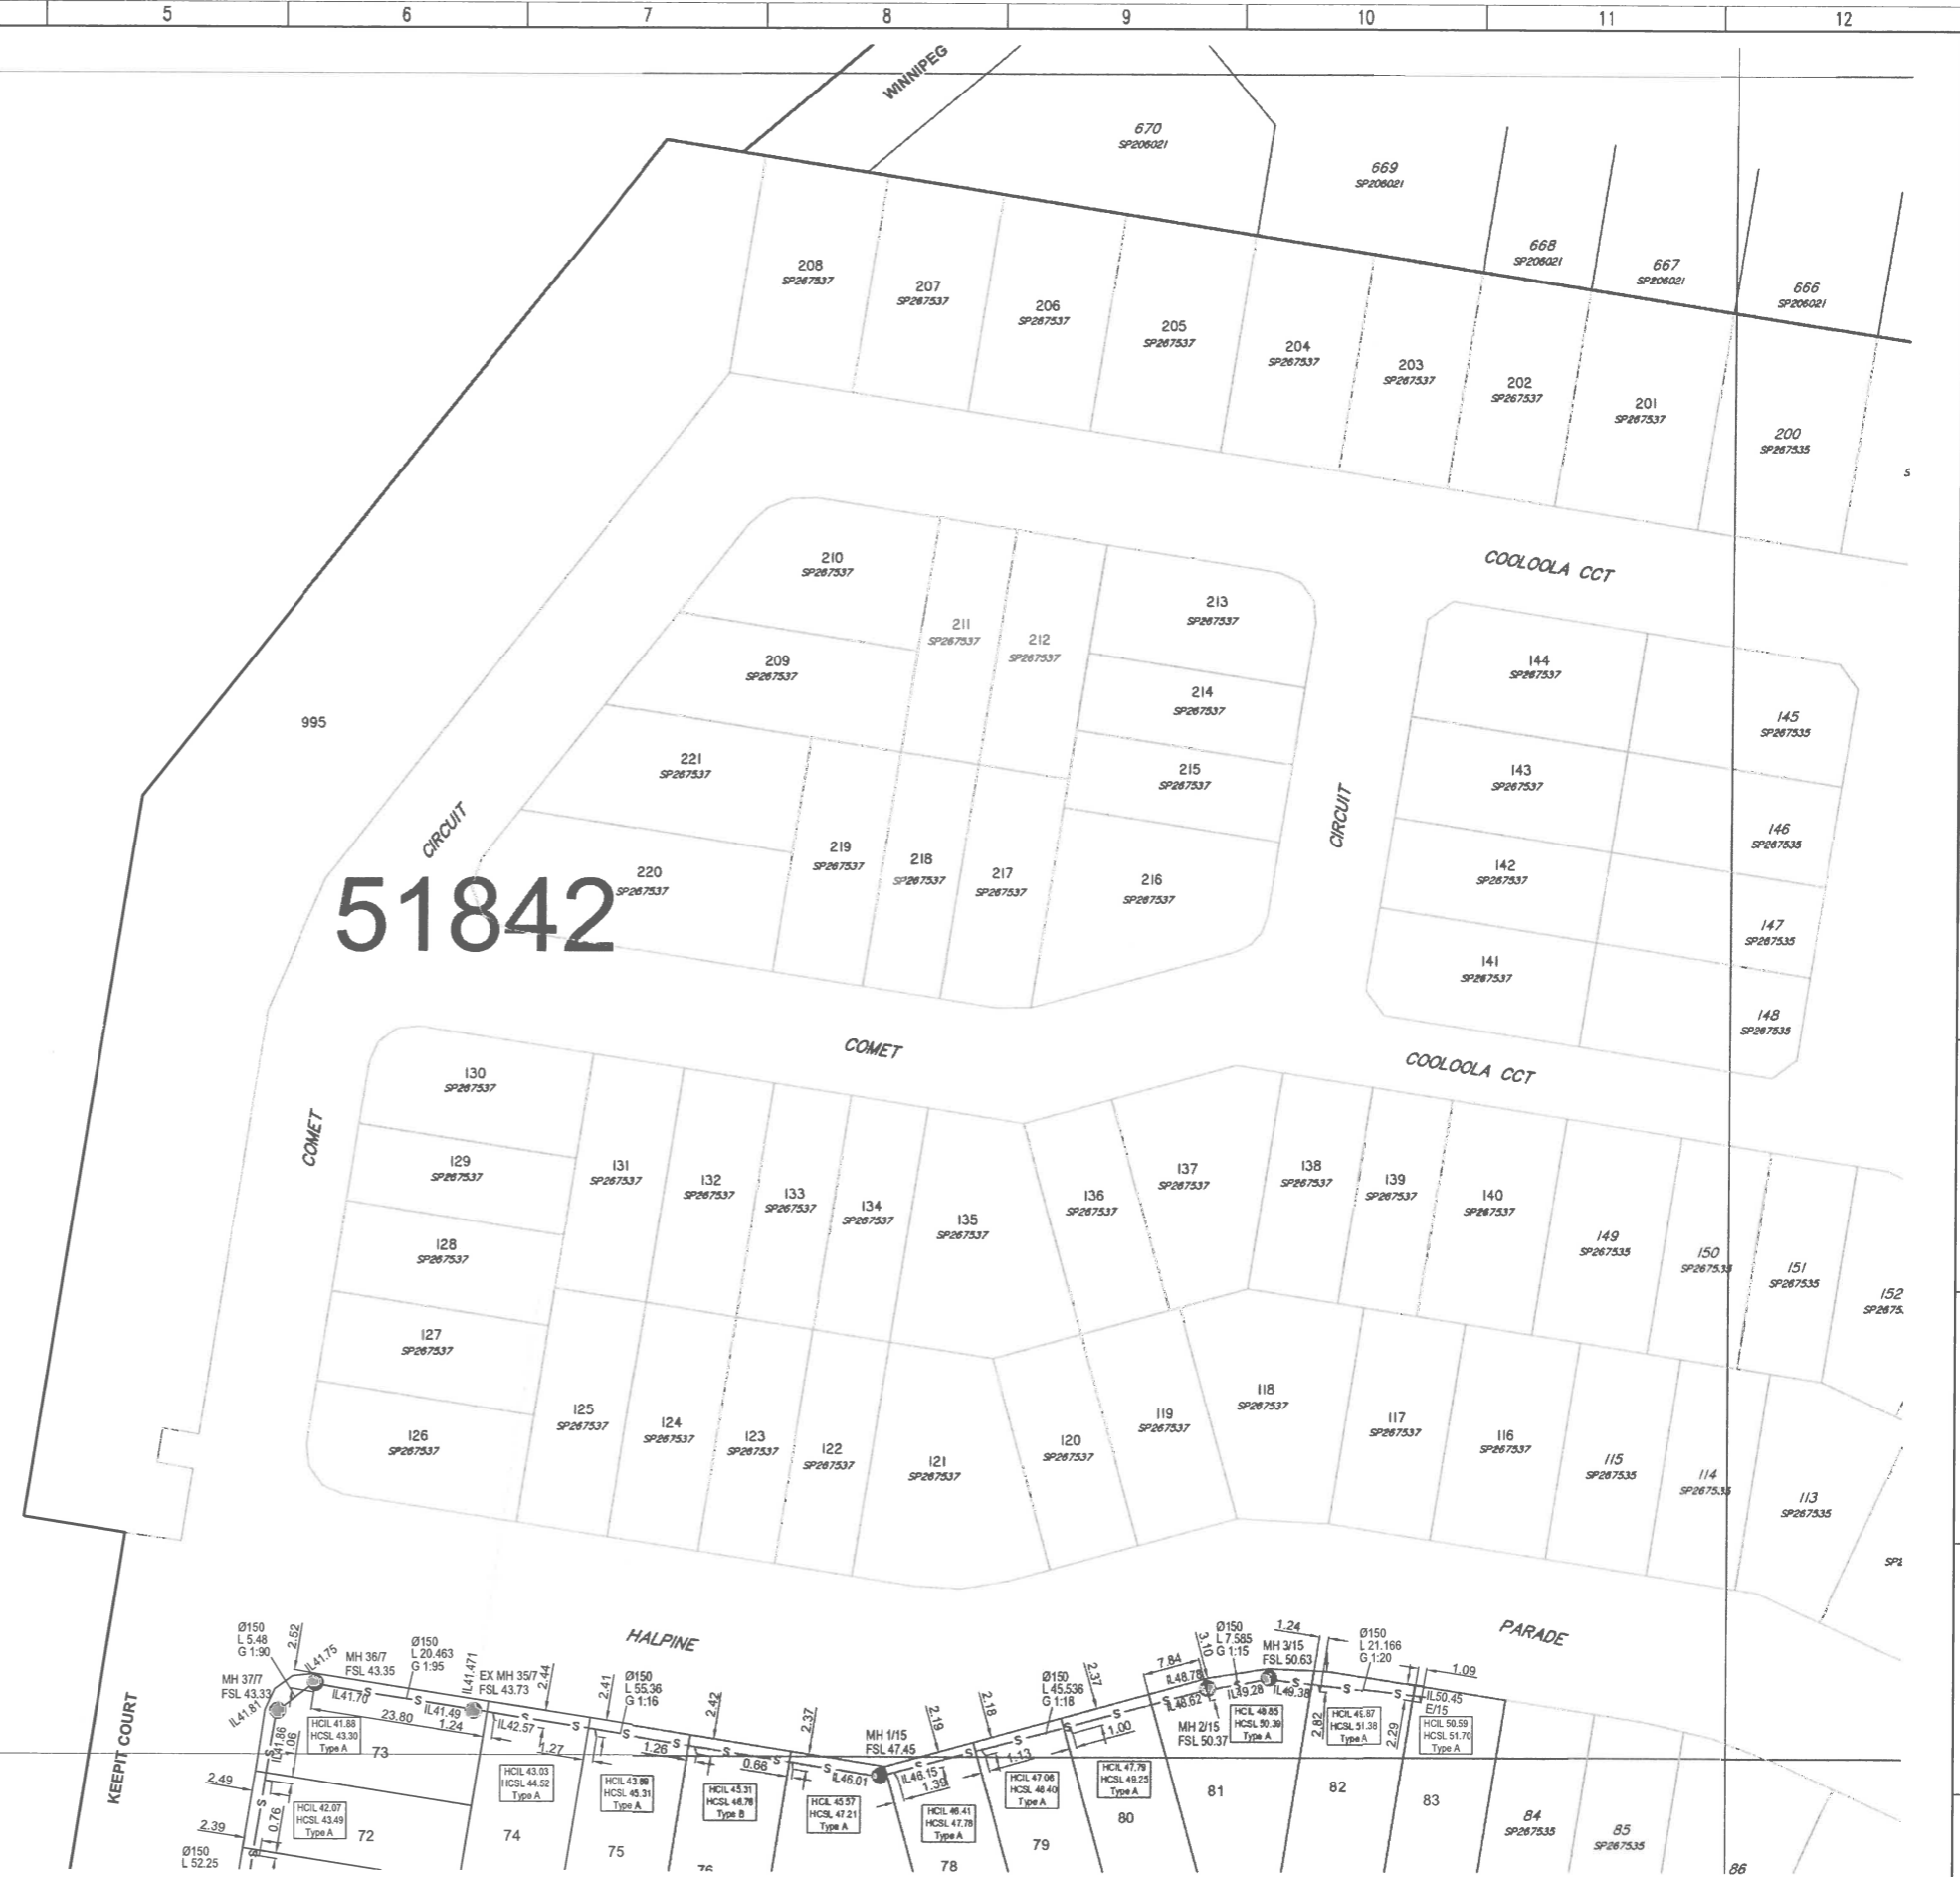

51842

DRAWING REVISIONS		REFERENCE DRAWINGS		DESIGN FILE No.	DESIGNED
REV.	REVISION DESCRIPTION	DRG. No.	DESCRIPTION	CONSTRUCT. No.	DATE
				S-7433-511	MG
				FIELD BOOK	22/08/16
				LOG BOOK	DH
				LEVEL DATUM	DATE
				DATUM	DATE

THIS WORK WAS PREPARED BY:
DEFENCE HOUSING AUSTRALIA



MORETON BAY REGIONAL COUNCIL
CABOOLTURE DISTRICT OFFICE
2 BASKING STREET CABOOLTURE QLD 4510
Telephone: (07) 5433 0100
Fax: (07) 5433 4000

WARNER SPRINGS ESTATE
Kremzow Road, Warner
Stage 2b

MBRC SUBDIVISION REFERENCE	
DA/20033/2008/V4DU/5	
No. 1 OF 2 PLANS	
ASCON GRID NUMBER	REV.
51842	

SCALE 1:500 ORIGINAL SIZE A1

'AS CONSTRUCTED' - SEWER

LEGEND

Ø	Pipe Diameter
L	Length
HC	House Connection
IL	Invert Level
SL	Surface Level
MH	Manhole
G	Grade
FSL	Finished Surface Level

NOTES

- All sewer mains are Ø150 uPVC Class SN8 unless otherwise stated
- All house connections are Ø100 uPVC Class SN10
- All sewer lines are at a 1.5m alignment to the boundary unless otherwise stated

We T.H.Jensen Bowers Pty. Ltd., Cadastral Surveyors, hereby certify that the "As Constructed" information contained in this drawing is accurate. We accept responsibility for, and acknowledge that the "As Constructed" information may be relied on by Council and Others.

[Signature]
Director


The as constructed assets shown hereon have been located and plotted for horizontal and vertical position only. Whilst due care and attention has been exercised, T.H Jensen Bowers Pty Ltd does not take responsibility for other attributes. These should be confirmed by the project engineer.

AS CONSTRUCTED CERTIFICATION

I, *[Signature]* hereby certify that:

- The information contained in this drawing/document is in compliance with the approved drawings and design.
- This represents an accurate record of as constructed works and I accept responsibility for the information in this drawing/document.

[Signature] RPEQ No. **11576** Date **22/11/16**
RPEQ (signature)

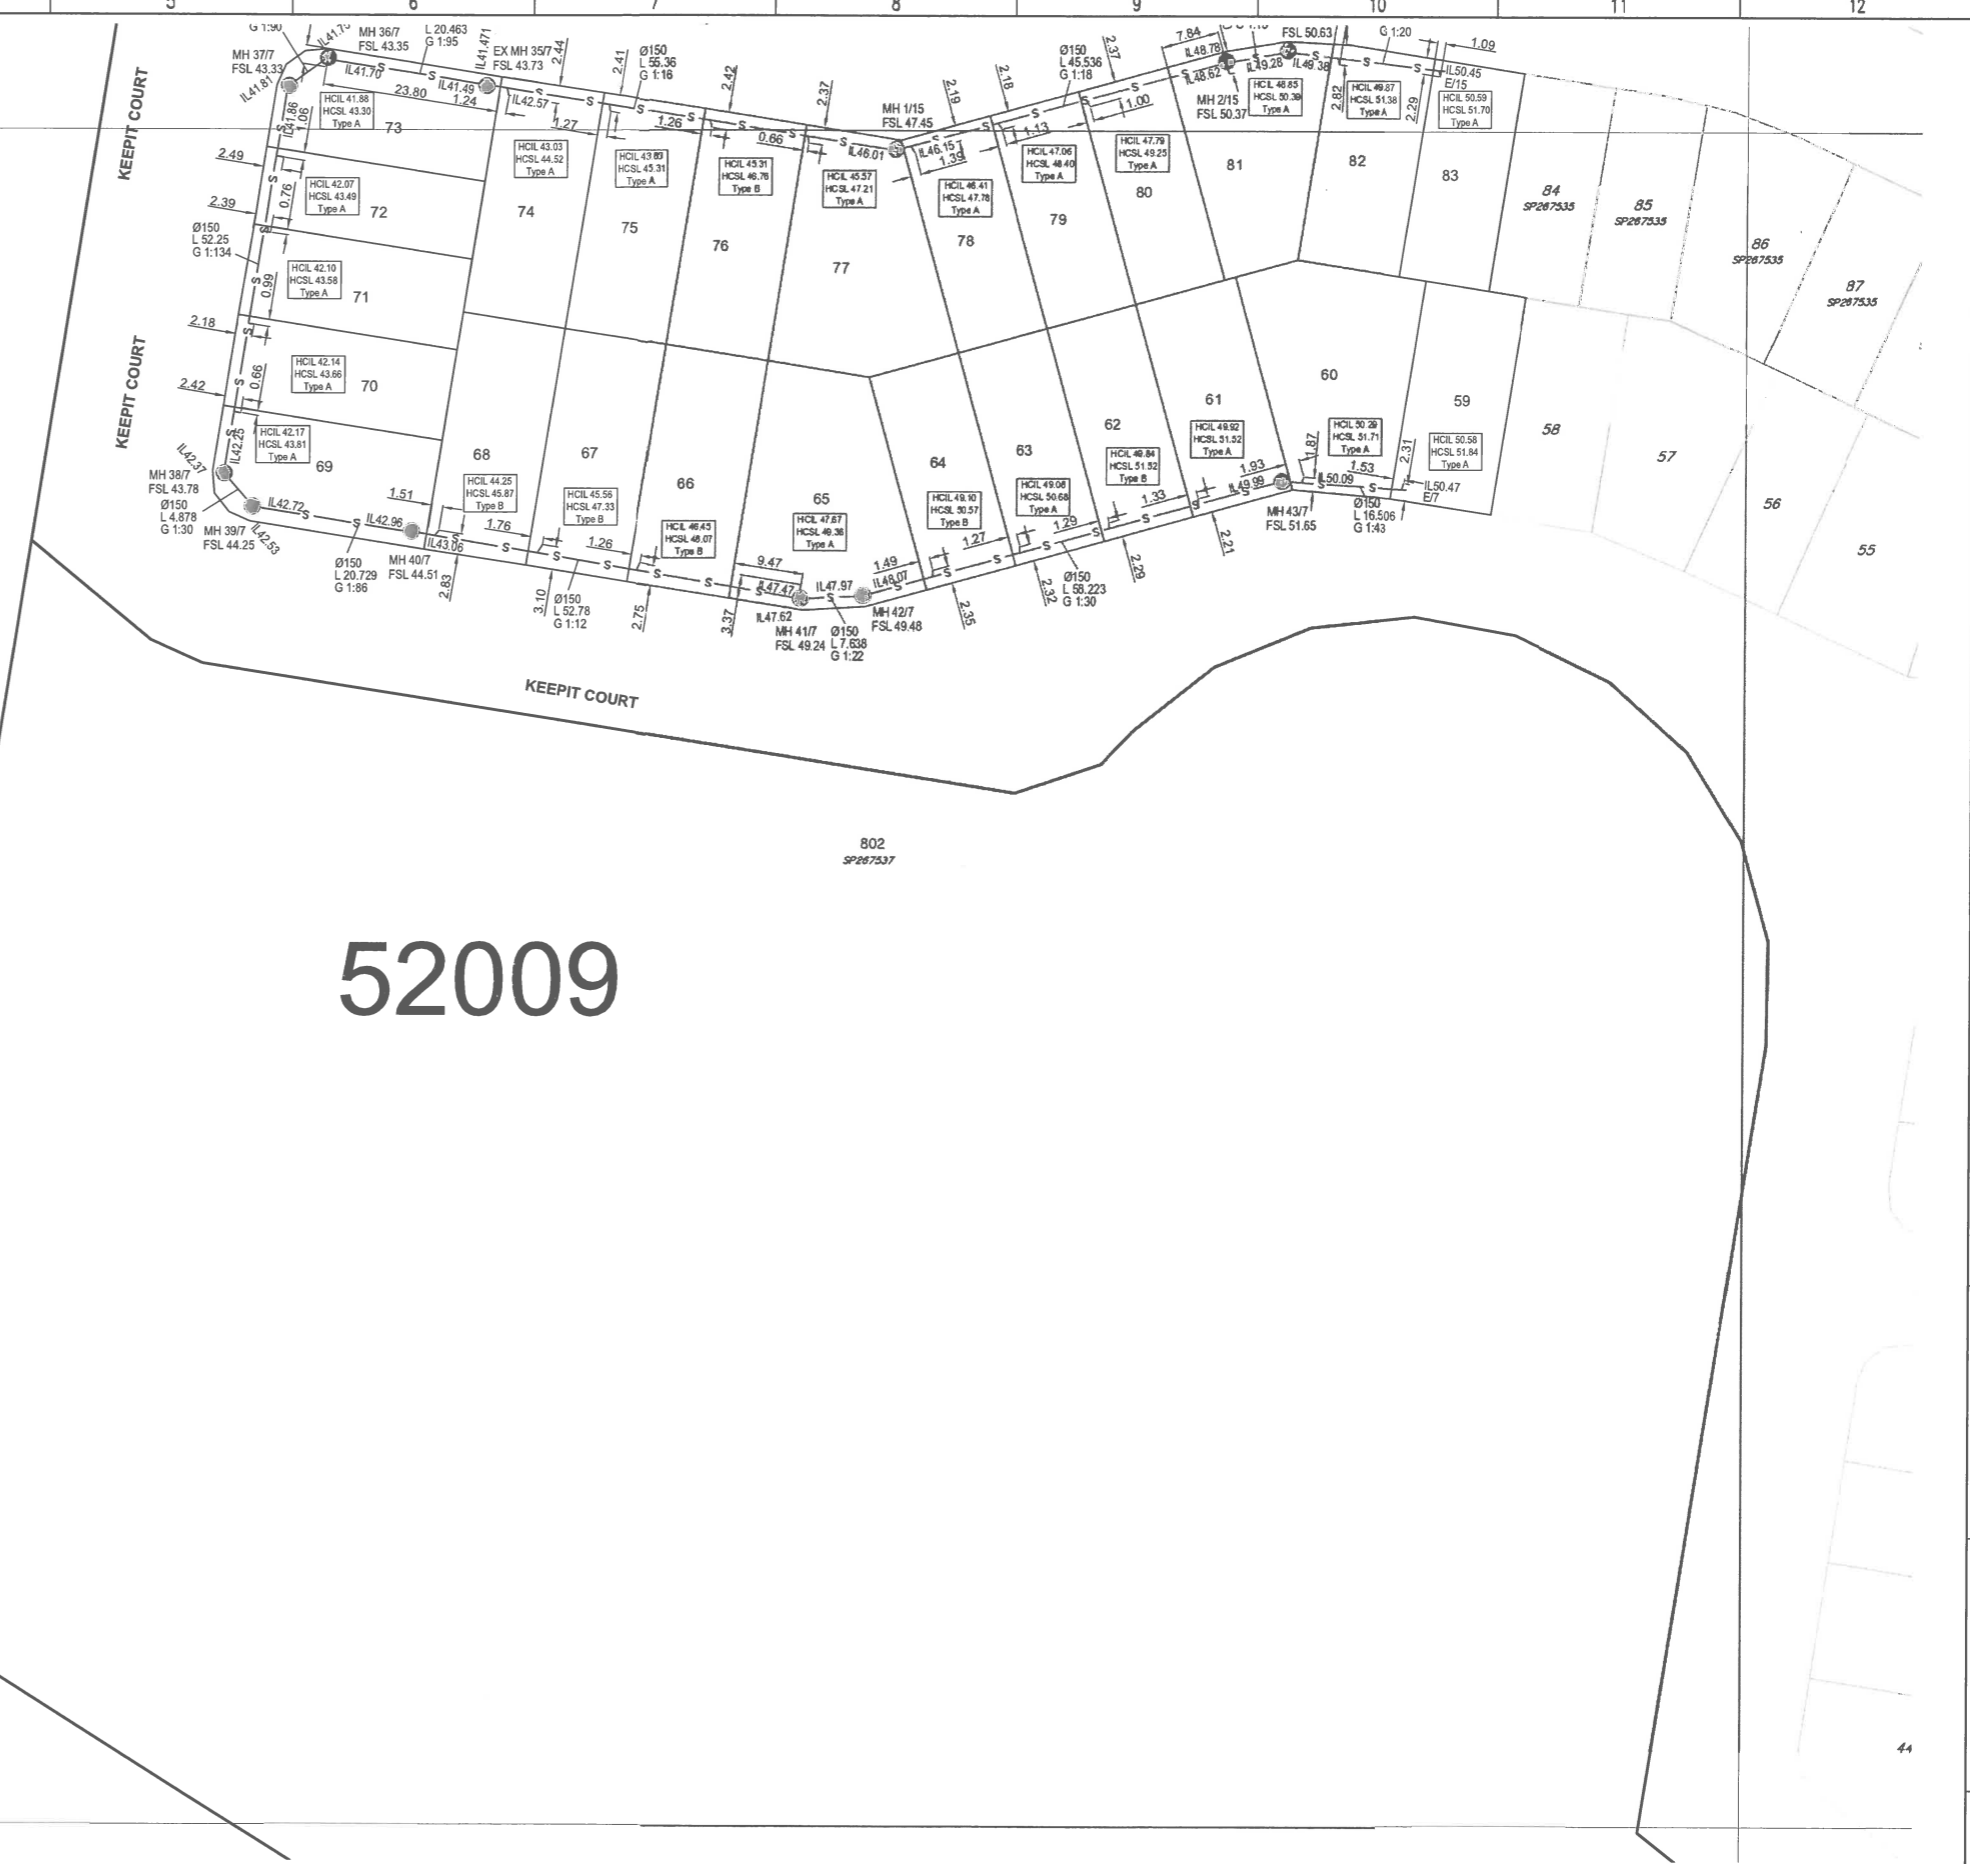

52009

DRAWING REVISIONS		REFERENCE DRAWINGS		DESIGN FILE No.	DESIGNED	DATE	DRAWN	MG	DATE	CHECKED	DH	DATE	THIS WORK WAS PREPARED BY:		Moreton Bay Regional Council	MOROTON BAY REGIONAL COUNCIL CABOOLTURE DISTRICT OFFICE 2 HASKING STREET CABOOLTURE QLD 4510 PO BOX 150 CABOOLTURE QLD 4510 Telephone: (07) 5433 0100 Fax: (07) 5433 4000	WARNER SPRINGS ESTATE Kremzow Road, Warner Stage 2b 'AS CONSTRUCTED' - SEWER	MBRC SUBDIVISION REFERENCE		
REV.	REVISION DESCRIPTION	DRG. No.	DESCRIPTION	CONSTRUCT. No.	DATE								SCALE 1:500	ORIGINAL SIZE A1				DA/20033/2008/V4DU/5	No. 2 OF 2 PLANS	ASCON GRID NUMBER
				S-7433-511					22/08/16										52009	