

52009



The as constructed assets shown hereon have been located and plotted for horizontal and vertical position only. Whilst due care and attention has been exercised, T.H Jensen Bowers Pty Ltd does not take responsibility for other attributes. These should be confirmed by the project engineer.

We T.H.Jensen Bowers Pty. Ltd., Cadastral Surveyors, hereby certify that the "As Constructed" information contained in this drawing is accurate. We accept responsibility for, and acknowledge that the "As Constructed" information may be relied on by Council and Others.

[Signature]
Director

LEGEND

Ø	Pipe Diameter
L	Length
HC	House Connection
IL	Invert Level
SL	Surface Level
MH	Manhole
G	Grade
FSL	Finished Surface Level

NOTES

All sewer mains are Ø150 uPVC Class SN8 unless otherwise stated
 All house connections are Ø100 uPVC Class SN10
 All sewer lines are at a 1.5m alignment to the boundary unless otherwise stated

AS CONSTRUCTED CERTIFICATION

I, *[Signature]* hereby certify that:

- The information contained in this drawing/document is in compliance with the approved drawings and design.
- This represents an accurate record of as constructed works and I accept responsibility for the information in this drawing/document.

[Signature] RPEQ No. *11578* Date *22/11/16*
RPEQ (signature)

DRAWING REVISIONS		REFERENCE DRAWINGS		DESIGN FILE No.	DESIGNED
REV.	REVISION DESCRIPTION	DRG. No.	DESCRIPTION	CONSTRUCT. No.	DATE
				S-7433-512	DRAWN MG
					DATE 22/08/16
					CHECKED DH
					DATE
				PMS7810 (R.47.338m)	
				MGA Zone 56	

THIS WORK WAS PREPARED BY:
DEFENCE HOUSING AUSTRALIA

SCALE 1:500 ORIGINAL SIZE A1

Moreton Bay
 Regional Council

MORETON BAY REGIONAL COUNCIL
 CABOOLTURE DISTRICT OFFICE
 2 HASKING STREET CABOOLTURE QLD 4510
 PO BOX 159 CABOOLTURE QLD 4510
 Telephone: (07) 5433 0100
 Fax: (07) 5433 4000

WARNER SPRINGS ESTATE
 Krenzw Road, Warner
 Stage 3


'AS CONSTRUCTED' - SEWER

MBCR SUBDIVISION REFERENCE

DA/20033/2008/V4DU/11

No. 1 OF 3 PLANS

ASCAN GRID NUMBER	REV.
52009	

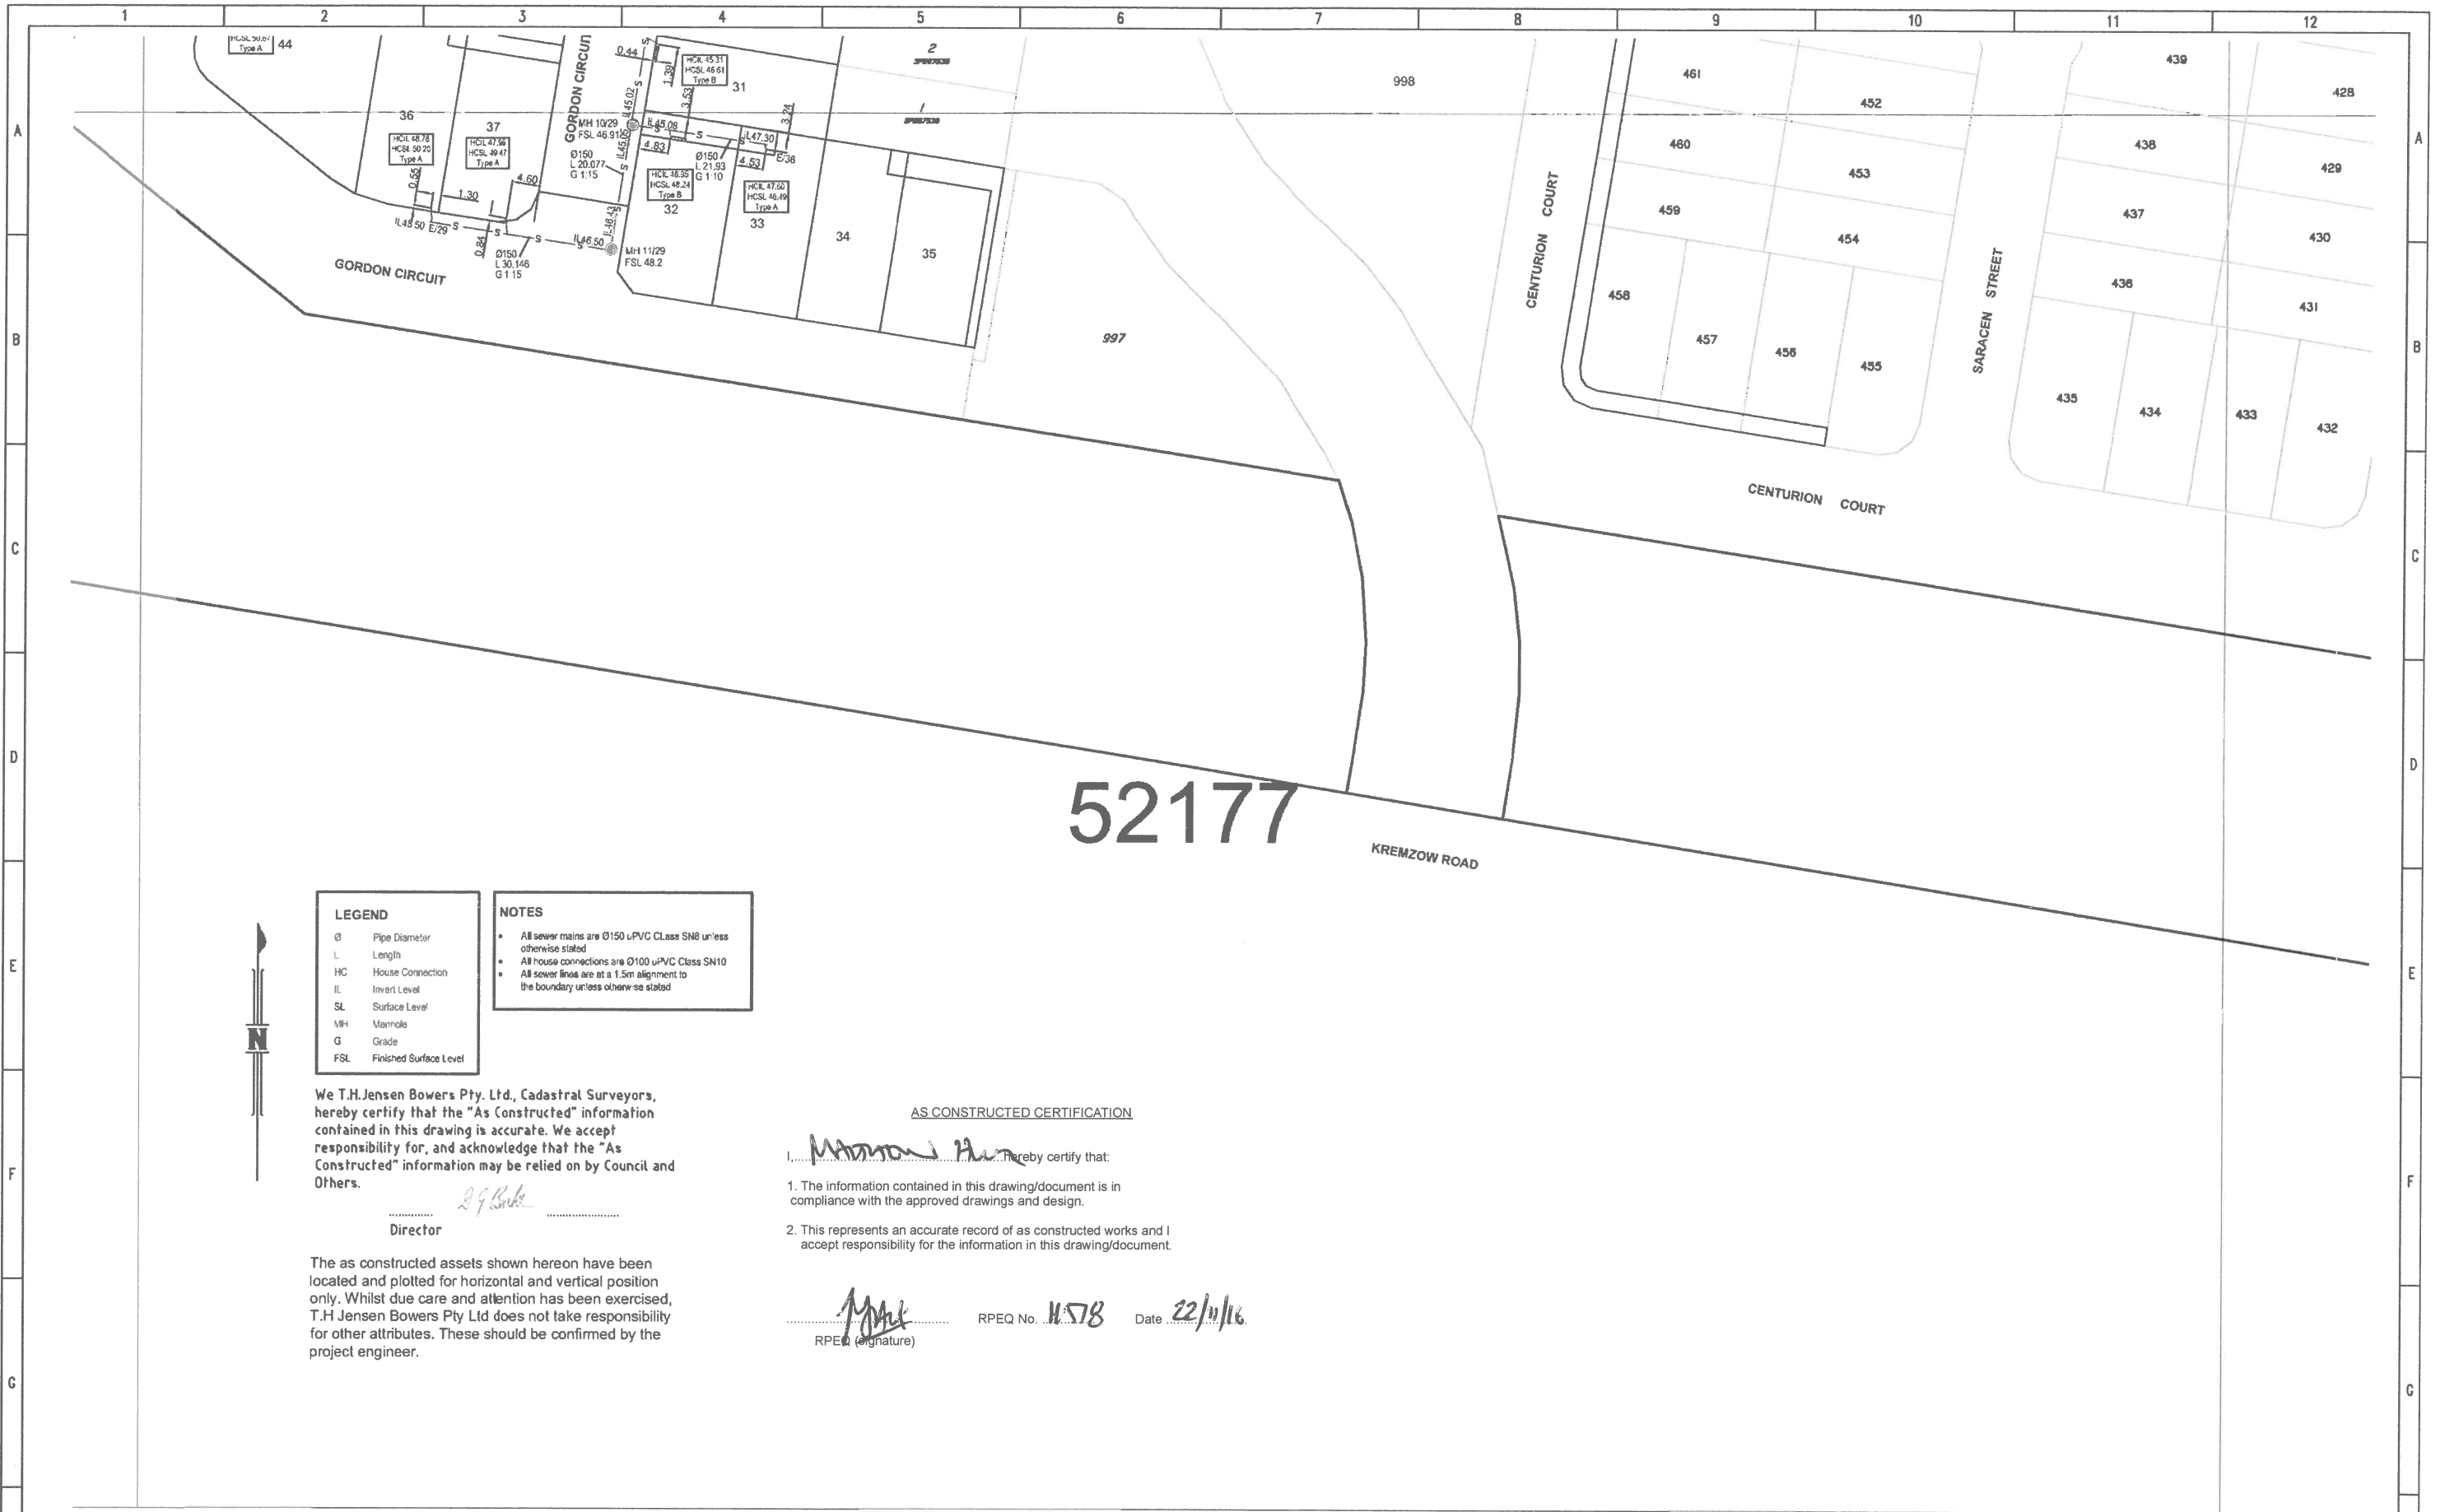

52177

LEGEND

Ø	Pipe Diameter
L	Length
HC	House Connection
IL	Invert Level
SL	Surface Level
MH	Manhole
G	Grade
FSL	Finished Surface Level

NOTES

- All sewer mains are Ø150 uPVC Class SN8 unless otherwise stated
- All house connections are Ø100 uPVC Class SN10
- All sewer lines are at a 1.5m alignment to the boundary unless otherwise stated



We T.H.Jensen Bowers Pty. Ltd., Cadastral Surveyors, hereby certify that the "As Constructed" information contained in this drawing is accurate. We accept responsibility for, and acknowledge that the "As Constructed" information may be relied on by Council and Others.

[Signature]
Director

The as constructed assets shown hereon have been located and plotted for horizontal and vertical position only. Whilst due care and attention has been exercised, T.H.Jensen Bowers Pty Ltd does not take responsibility for other attributes. These should be confirmed by the project engineer.

AS CONSTRUCTED CERTIFICATION

[Signature] I hereby certify that:

- The information contained in this drawing/document is in compliance with the approved drawings and design.
- This represents an accurate record of as constructed works and I accept responsibility for the information in this drawing/document.

[Signature] RPEQ No. 11578 Date 22/08/16
RPEQ (signature)

DRAWING REVISIONS REV. REVISION DESCRIPTION		REFERENCE DRAWINGS DRG. No. DESCRIPTION		DESIGN FILE No. CONSTRUCT. No.	DESIGNED DATE	THIS WORK WAS PREPARED BY: DEFENCE HOUSING AUSTRALIA Moreton Bay Regional Council	MORETON BAY REGIONAL COUNCIL CABOOLTURE DISTRICT OFFICE 2 HASKING STREET CABOOLTURE QLD 4610 PO BOX 166 CABOOLTURE QLD 4610 Telephone: (07) 5433 0100 Fax: (07) 5433 4800	WARNER SPRINGS ESTATE Kremzow Road, Warner Stage 3 'AS CONSTRUCTED' - SEWER	MBRC SUBMISSION REFERENCE DA/20033/2008/V4DU/11	
				SURVEY FILE No. S-7433-512 FIELD BOOK LOG BOOK	DRAWN MG DATE 22/08/16 CHECKED DH				No. 3 OF 3 PLANS ASCON GRID NUMBER REV.	
				LEVEL DATUM DATUM	DATE				52177	
				MCA Zone 05	SCALE 1:500				ORIGINAL SIZE A1	