

Legend	
---	Road Crown
---	Edge of Bitumen
---	Edge Track
---	Road Kerb Invert
---	Bottom of Bank
---	Top of Bank
---	Change of Grade
---	Retaining Wall
---	Contour Major
---	Contour Minor

The as constructed assets shown hereon have been located and plotted for horizontal and vertical position only. Whilst due care and attention has been exercised, T.H Jensen Bowers Pty Ltd does not take responsibility for other attributes. These should be confirmed by the project engineer.

We T.H.Jensen Bowers Pty. Ltd., Cadastral Surveyors, hereby certify that the "As Constructed" information contained in this drawing is accurate. We accept responsibility for, and acknowledge that the "As Constructed" information may be relied on by Council and Others.

[Signature]
Director

AS CONSTRUCTED CERTIFICATION

I, *[Signature]* hereby certify that:

- The information contained in this drawing/document is in compliance with the approved drawings and design.
- This represents an accurate record of as constructed works and I accept responsibility for the information in this drawing/document.

[Signature] RPEQ No. **11578** Date **25/11/16**
RPEQ (signature)

DRAWING REVISIONS		REFERENCE DRAWINGS		DESIGN FILE No.	DESIGNED
REV.	REVISION DESCRIPTION	DRG. No.	DESCRIPTION	CONSTRUCT. No.	DATE

THIS WORK WAS PREPARED BY:
DEFENCE HOUSING AUSTRALIA


SCALE 1:500 ORIGINAL SIZE A1



MORETON BAY REGIONAL COUNCIL
CABOOLTURE DISTRICT OFFICE
2 HASKING STREET CABOOLTURE QLD 4510
PO BOX 159 CABOOLTURE QLD 4510
Telephone: (07) 5433 0100
Fax: (07) 5433 4000

WARNER SPRINGS ESTATE
Kremzow Road, Warner
Stage 2b
'AS CONSTRUCTED' - FINISHED SURFACE

MBRC SUBDIVISION REFERENCE	
DA/20033/2008/V4DU/5	No. 1 OF 2 PLANS
ASCON GRID NUMBER	REV.
51842	

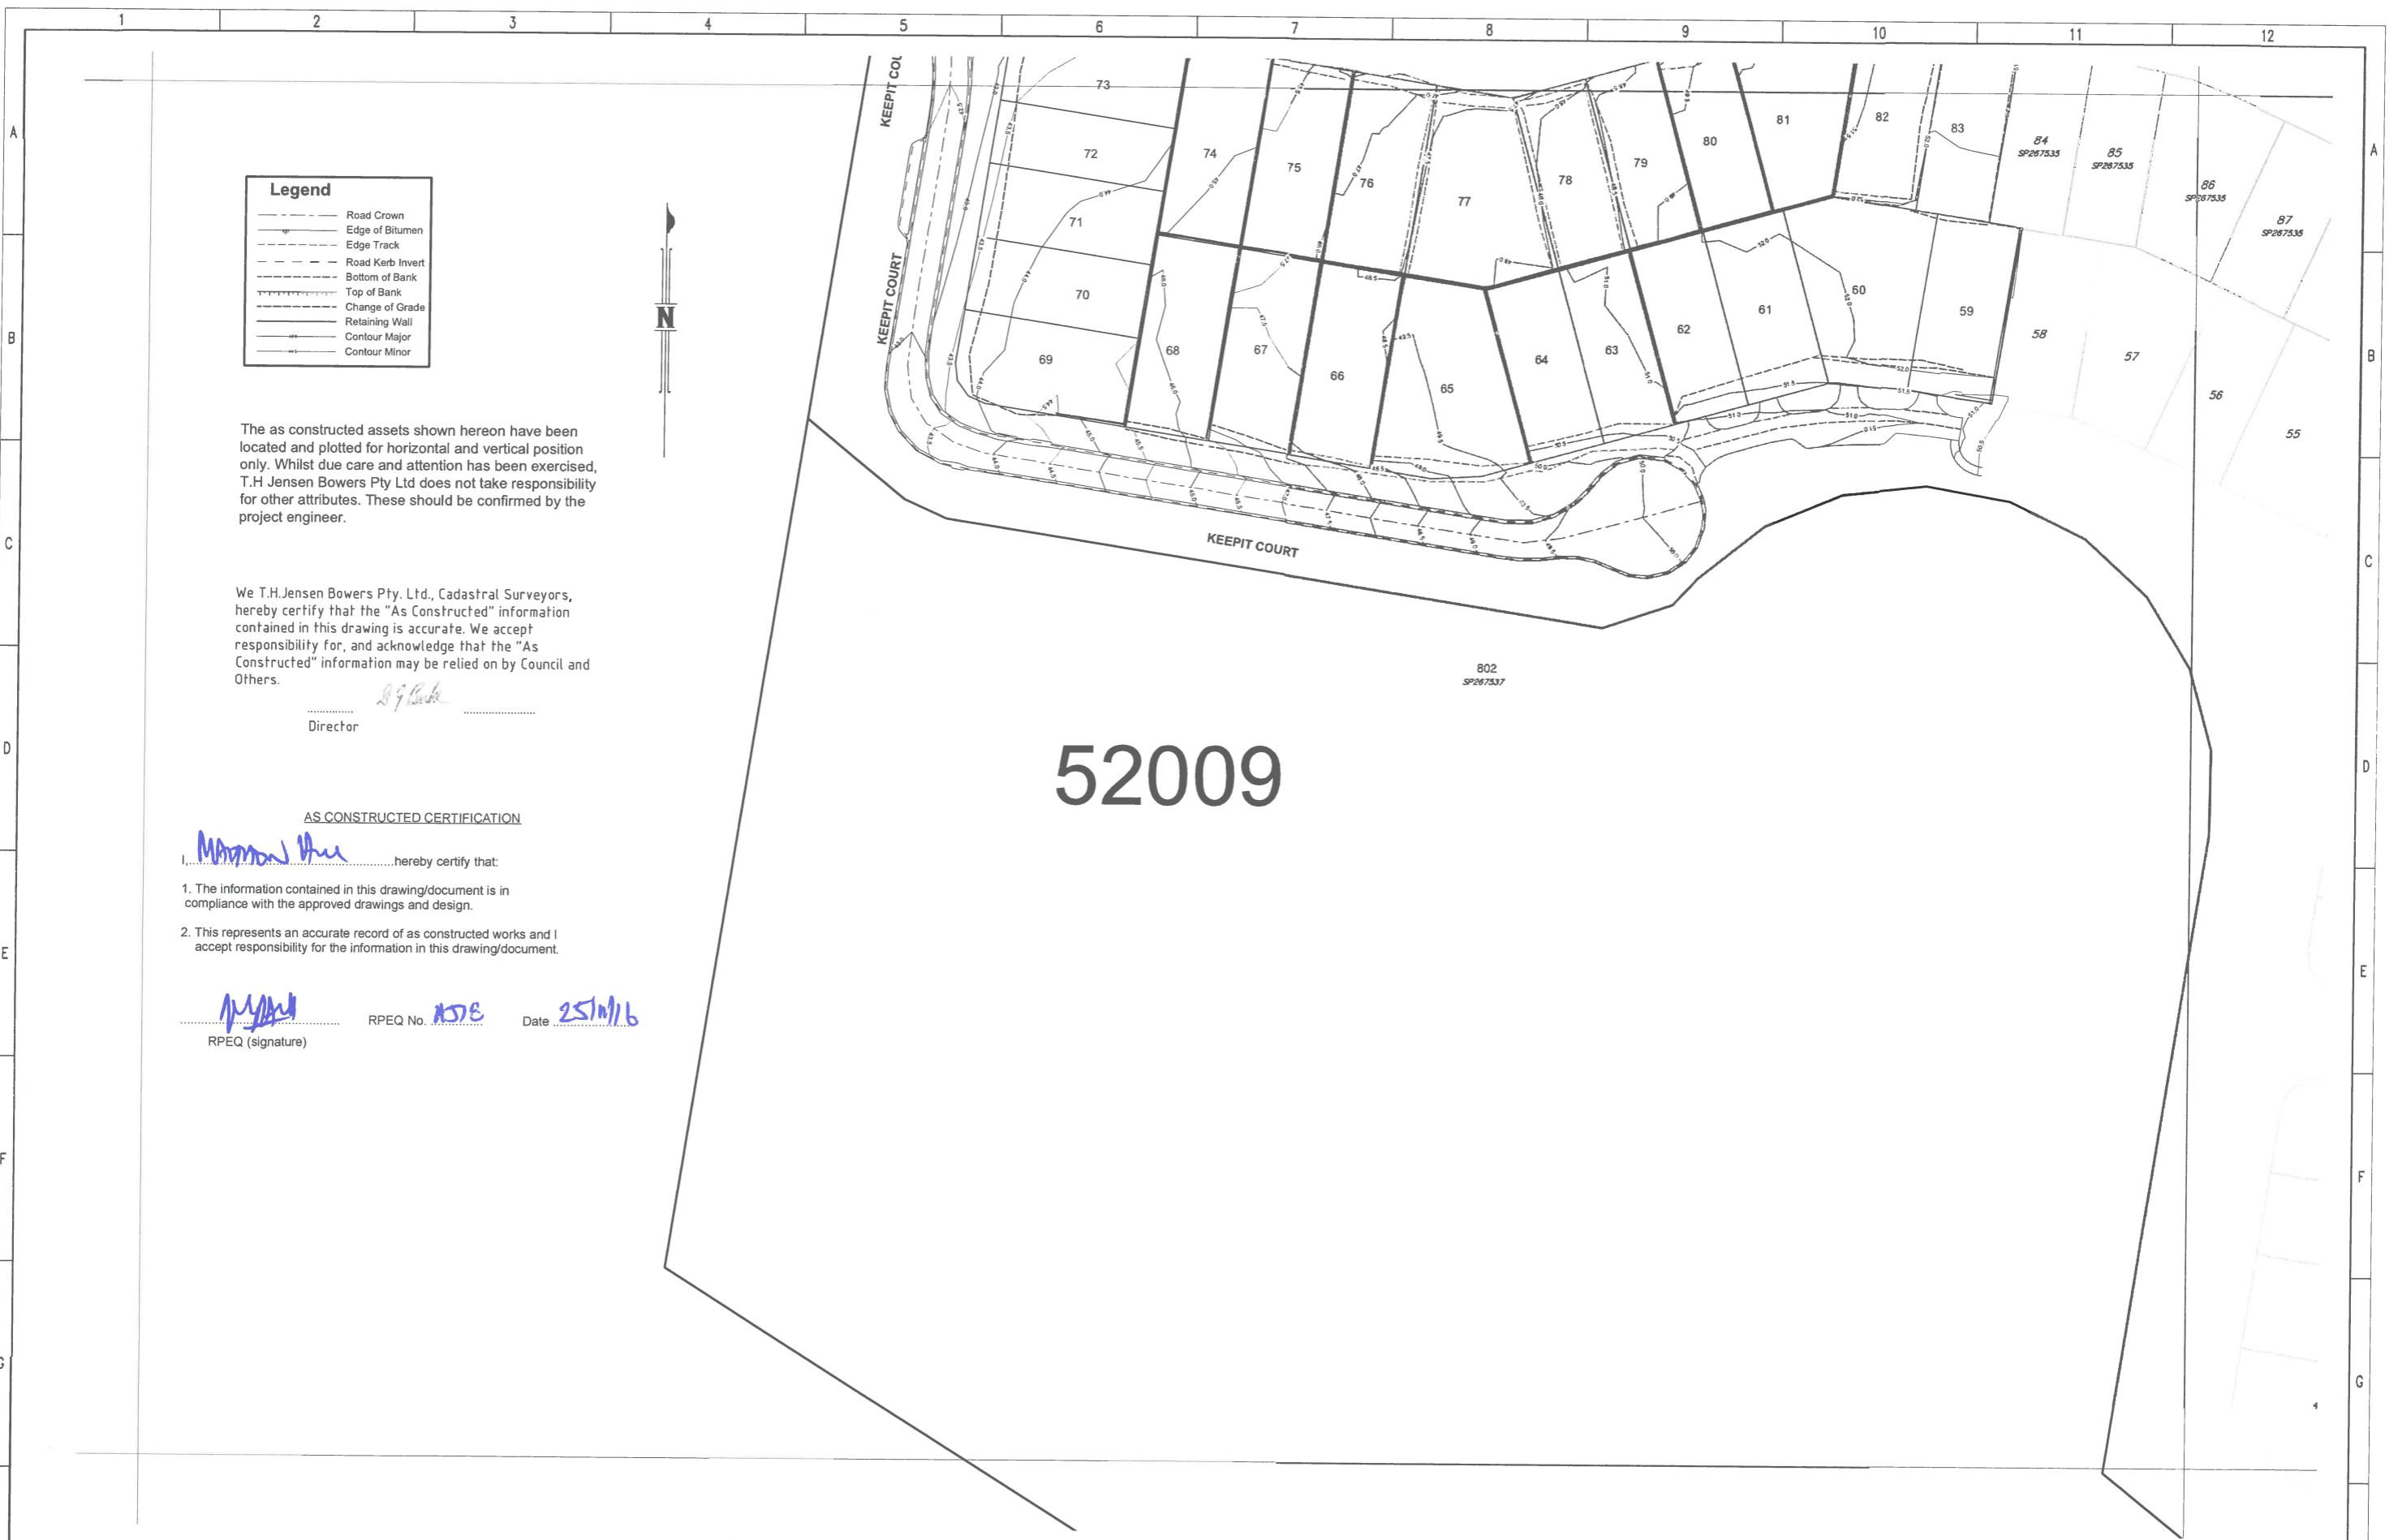

Legend

---	Road Crown
---	Edge of Bitumen
---	Edge Track
---	Road Kerb Invert
---	Bottom of Bank
---	Top of Bank
---	Change of Grade
---	Retaining Wall
---	Contour Major
---	Contour Minor



The as constructed assets shown hereon have been located and plotted for horizontal and vertical position only. Whilst due care and attention has been exercised, T.H Jensen Bowers Pty Ltd does not take responsibility for other attributes. These should be confirmed by the project engineer.

We T.H.Jensen Bowers Pty. Ltd., Cadastral Surveyors, hereby certify that the "As Constructed" information contained in this drawing is accurate. We accept responsibility for, and acknowledge that the "As Constructed" information may be relied on by Council and Others.

[Signature]
Director

AS CONSTRUCTED CERTIFICATION

I, *[Signature]* hereby certify that:

1. The information contained in this drawing/document is in compliance with the approved drawings and design.
2. This represents an accurate record of as constructed works and I accept responsibility for the information in this drawing/document.

[Signature] RPEQ No. *157E* Date *25/10/16*
RPEQ (signature)

52009

DRAWING REVISIONS REV. REVISION DESCRIPTION		REFERENCE DRAWINGS DRG. No. DESCRIPTION		DESIGN FILE No. CONSTRUCT. No. SURVEY FILE No. S-7433-511 FIELD BOOK LOG BOOK LEVEL DATUM DATUM <small>(RL47338m) MGA Zone 56</small>		DESIGNED DATE DRAWN DATE CHECKED DATE MG WG		THIS WORK WAS PREPARED BY: DEFENCE HOUSING AUSTRALIA		 MORETON BAY REGIONAL COUNCIL CABOOLTURE DISTRICT OFFICE 2 HASKING STREET CABOOLTURE QLD 4510 PO BOX 159 CABOOLTURE QLD 4510 Telephone: (07) 5433 0100 Fax: (07) 5433 4000		WARNER SPRINGS ESTATE Kremzow Road, Warner Stage 2b 'AS CONSTRUCTED' - FINISHED SURFACE		MBRC SUBDIVISION REFERENCE DA/20033/2008/V4DU/5 No. 2 OF 2 PLANS ASCON GRID NUMBER 52009	
---	--	---	--	--	--	--	--	---	--	--	--	---	--	--	--