

52009



Legend	
	Road Crown
	Edge of Bitumen
	Edge Track
	Road Kerb Invert
	Bottom of Bank
	Top of Bank
	Change of Grade
	Retaining Wall
	Contour Major
	Contour Minor

The as constructed assets shown hereon have been located and plotted for horizontal and vertical position only. Whilst due care and attention has been exercised, T.H Jensen Bowers Pty Ltd does not take responsibility for other attributes. These should be confirmed by the project engineer.

We T.H.Jensen Bowers Pty. Ltd., Cadastral Surveyors, hereby certify that the "As Constructed" information contained in this drawing is accurate. We accept responsibility for, and acknowledge that the "As Constructed" information may be relied on by Council and Others.

[Signature]
Director

AS CONSTRUCTED CERTIFICATION

I, *Matthew Hill* hereby certify that:

1. The information contained in this drawing/document is in compliance with the approved drawings and design.
2. This represents an accurate record of as constructed works and I accept responsibility for the information in this drawing/document.


[Signature] RPEQ No. *1478* Date *25/10/16*
RPEQ (signature)

DRAWING REVISIONS		REFERENCE DRAWINGS		DESIGN FILE No.	DESIGNED	THIS WORK WAS PREPARED BY: DEFENCE HOUSING AUSTRALIA		MORETON BAY REGIONAL COUNCIL CABOOLTURE DISTRICT OFFICE 2 HASKING STREET CABOOLTURE QLD 4510 PO BOX 159 CABOOLTURE QLD 4510 Telephone: (07) 5433 0100 Fax: (07) 5433 4000	WARNER SPRINGS ESTATE Kremzow Road, Warner Stage 3 'AS CONSTRUCTED' - FINISHED SURFACE	MBRC SUBMISSION REFERENCE	
REV.	REVISION DESCRIPTION	DRG. No.	DESCRIPTION	CONSTRUCT. No.	DATE					DA/20033/2008/V4DU/11	No. 1 OF 3 PLANS
				S-7433-512	DRAWN	JM				ASCON GRID NUMBER	REV.
					DATE	27/10/16				52009	
					CHECKED	DH					
					DATE						
					LEVEL DATUM	PMS2010 (RL27.338m)					
					DATUM	MGA Zone 56					

SCALE 1:500 ORIGINAL SIZE A1

'AS CONSTRUCTED' - FINISHED SURFACE

52009

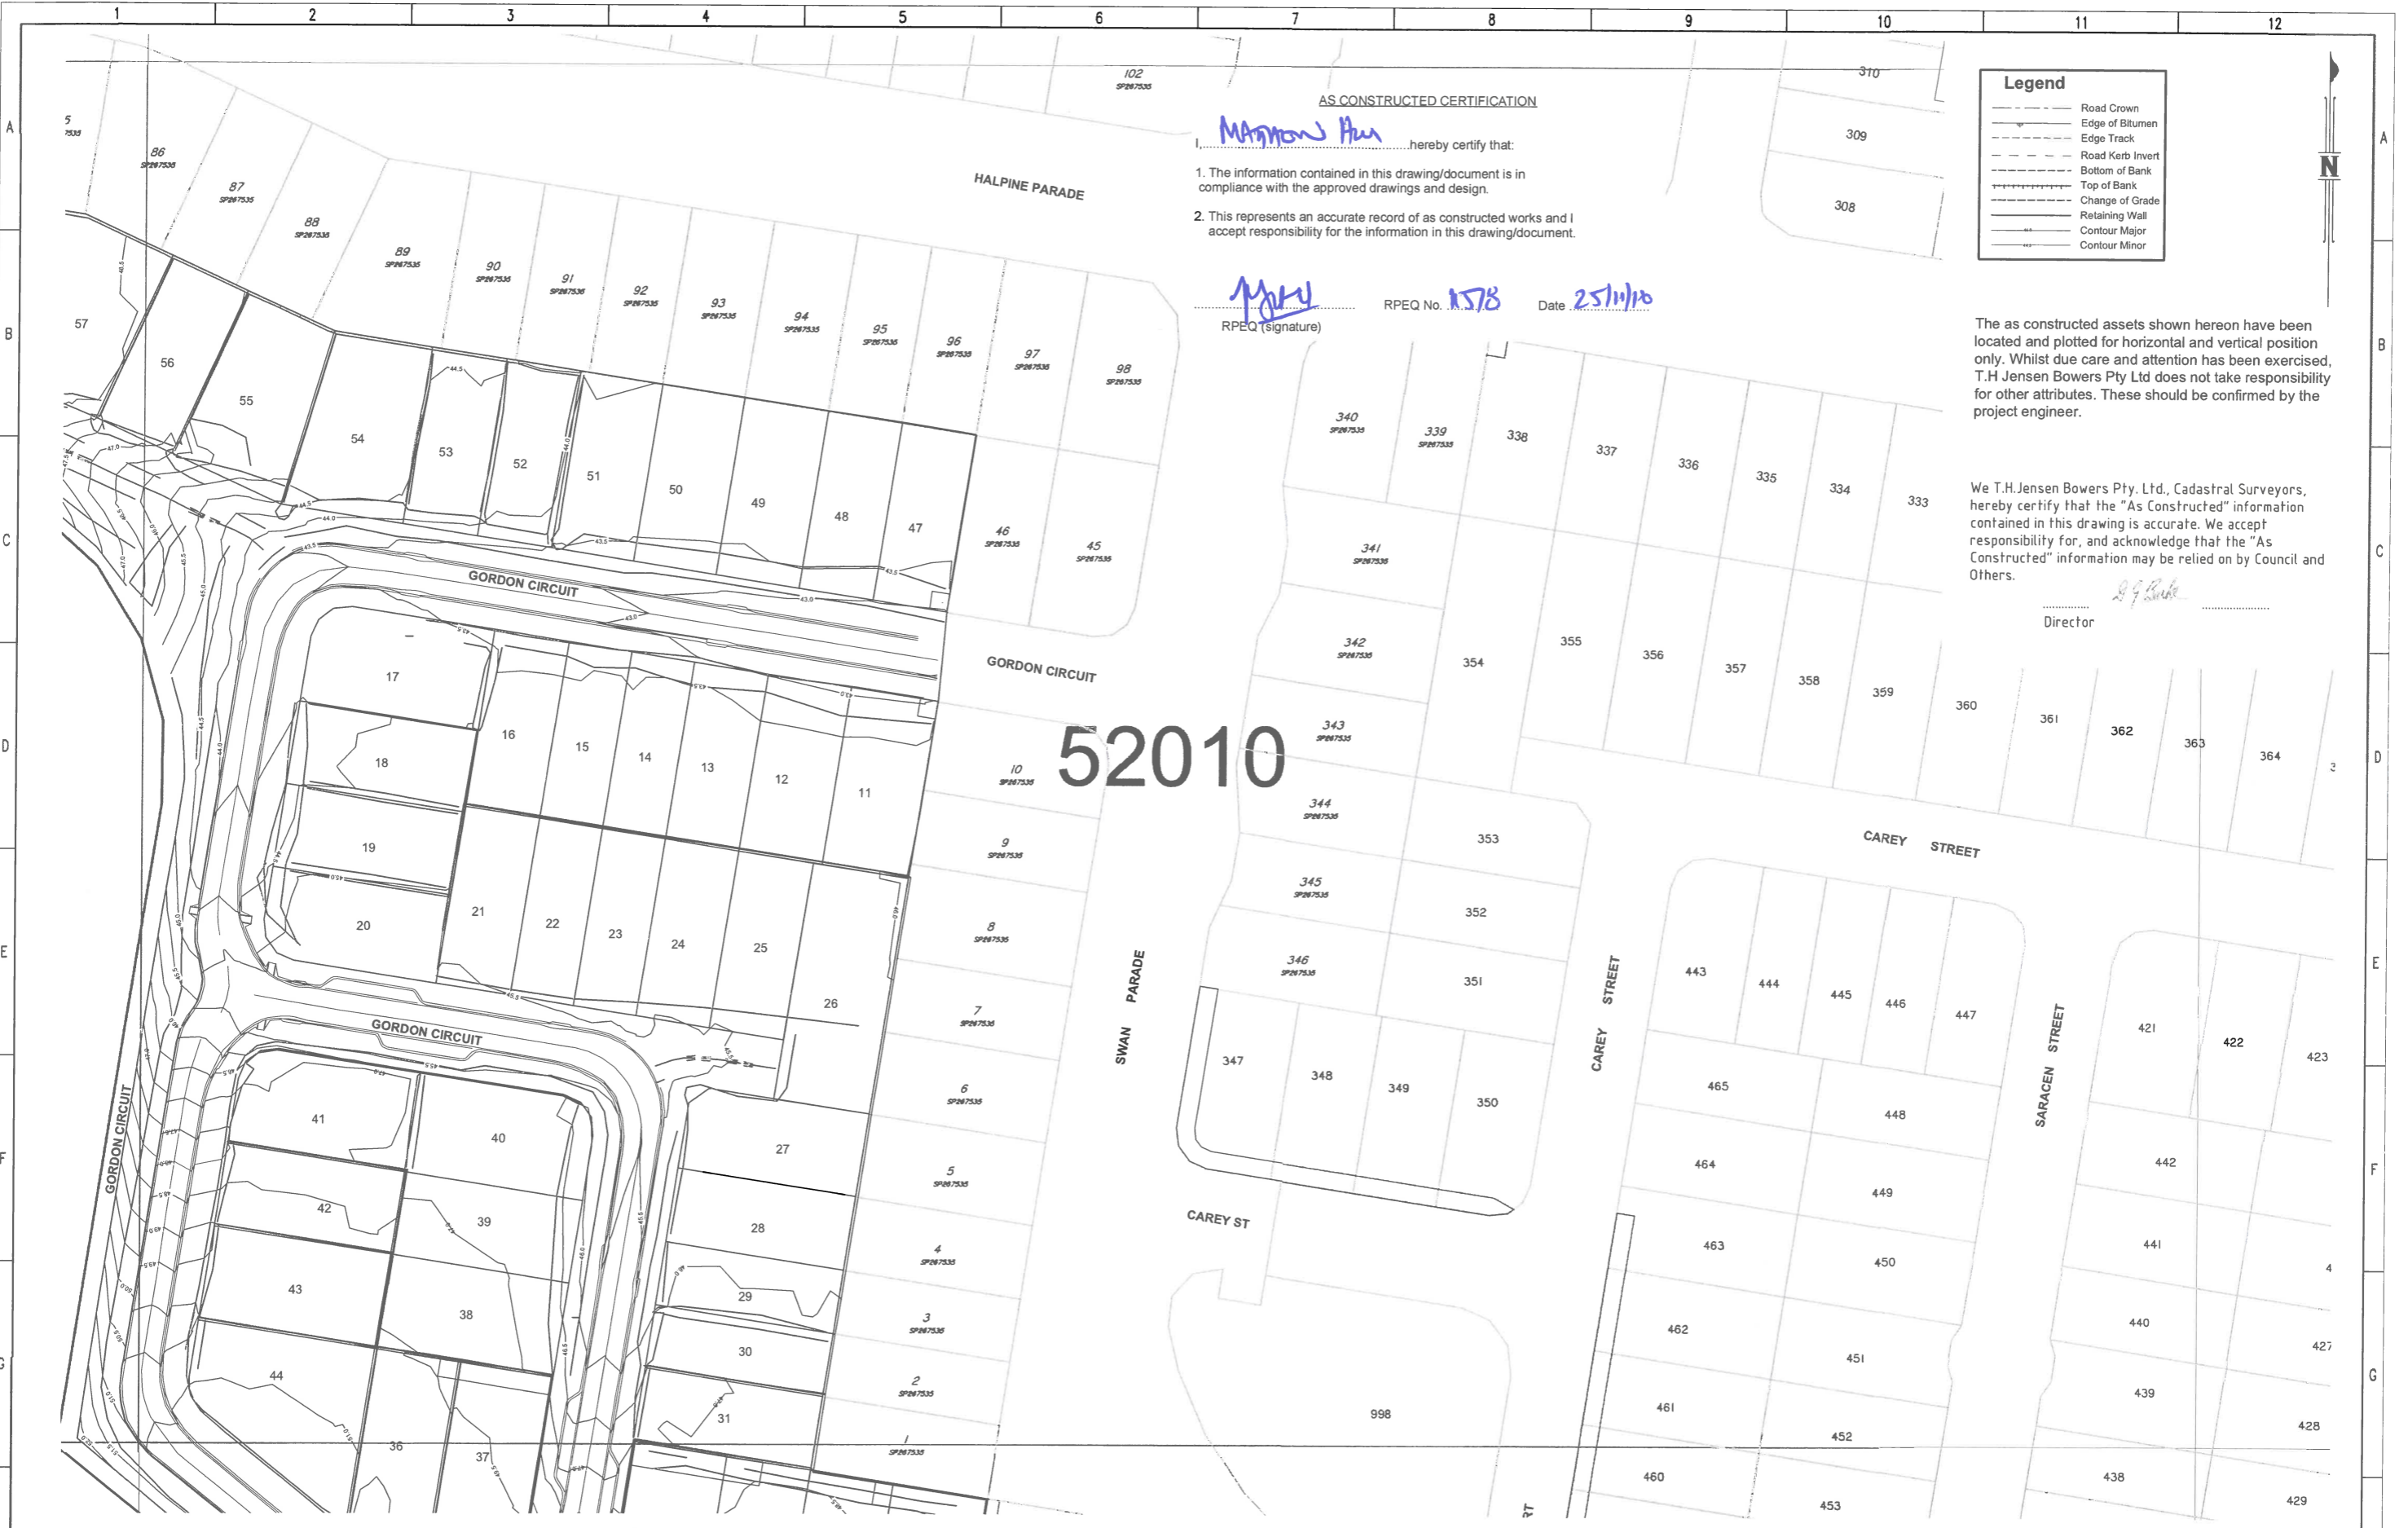

Legend	
	Road Crown
	Edge of Bitumen
	Edge Track
	Road Kerb Invert
	Bottom of Bank
	Top of Bank
	Change of Grade
	Retaining Wall
	Contour Major
	Contour Minor

AS CONSTRUCTED CERTIFICATION

I, Matthew Hill hereby certify that:
 1. The information contained in this drawing/document is in compliance with the approved drawings and design.
 2. This represents an accurate record of as constructed works and I accept responsibility for the information in this drawing/document.

M Hill
 RPEQ (signature) RPEQ No. 1578 Date 25/11/10

The as constructed assets shown hereon have been located and plotted for horizontal and vertical position only. Whilst due care and attention has been exercised, T.H Jensen Bowers Pty Ltd does not take responsibility for other attributes. These should be confirmed by the project engineer.

We T.H.Jensen Bowers Pty. Ltd., Cadastral Surveyors, hereby certify that the "As Constructed" information contained in this drawing is accurate. We accept responsibility for, and acknowledge that the "As Constructed" information may be relied on by Council and Others.

S J Burt
 Director

52010

DRAWING REVISIONS		REFERENCE DRAWINGS		DESIGN FILE No.		DESIGNED	
REV.	REVISION DESCRIPTION	DRG. No.	DESCRIPTION	CONSTRUCT. No.	SURVEY FILE No.	DATE	DATE
					S-7433-512	27/10/16	JM
							DH

THIS WORK WAS PREPARED BY:
DEFENCE HOUSING AUSTRALIA


SCALE 1:500 ORIGINAL SIZE A1



MORETON BAY REGIONAL COUNCIL
 CABOOLTURE DISTRICT OFFICE
 2 BASKING STREET CABOOLTURE QLD 4510
 Telephone: (07) 5433 0100
 Fax: (07) 5433 4000

WARNER SPRINGS ESTATE
 Kremzow Road, Warner
 Stage 3
 'AS CONSTRUCTED' - FINISHED SURFACE

MBRC SUBDIVISION REFERENCE	
DA/20033/2008/V4DU/11	
No. 2 OF 3 PLANS	
ASCON GRID NUMBER	REV.
52010	

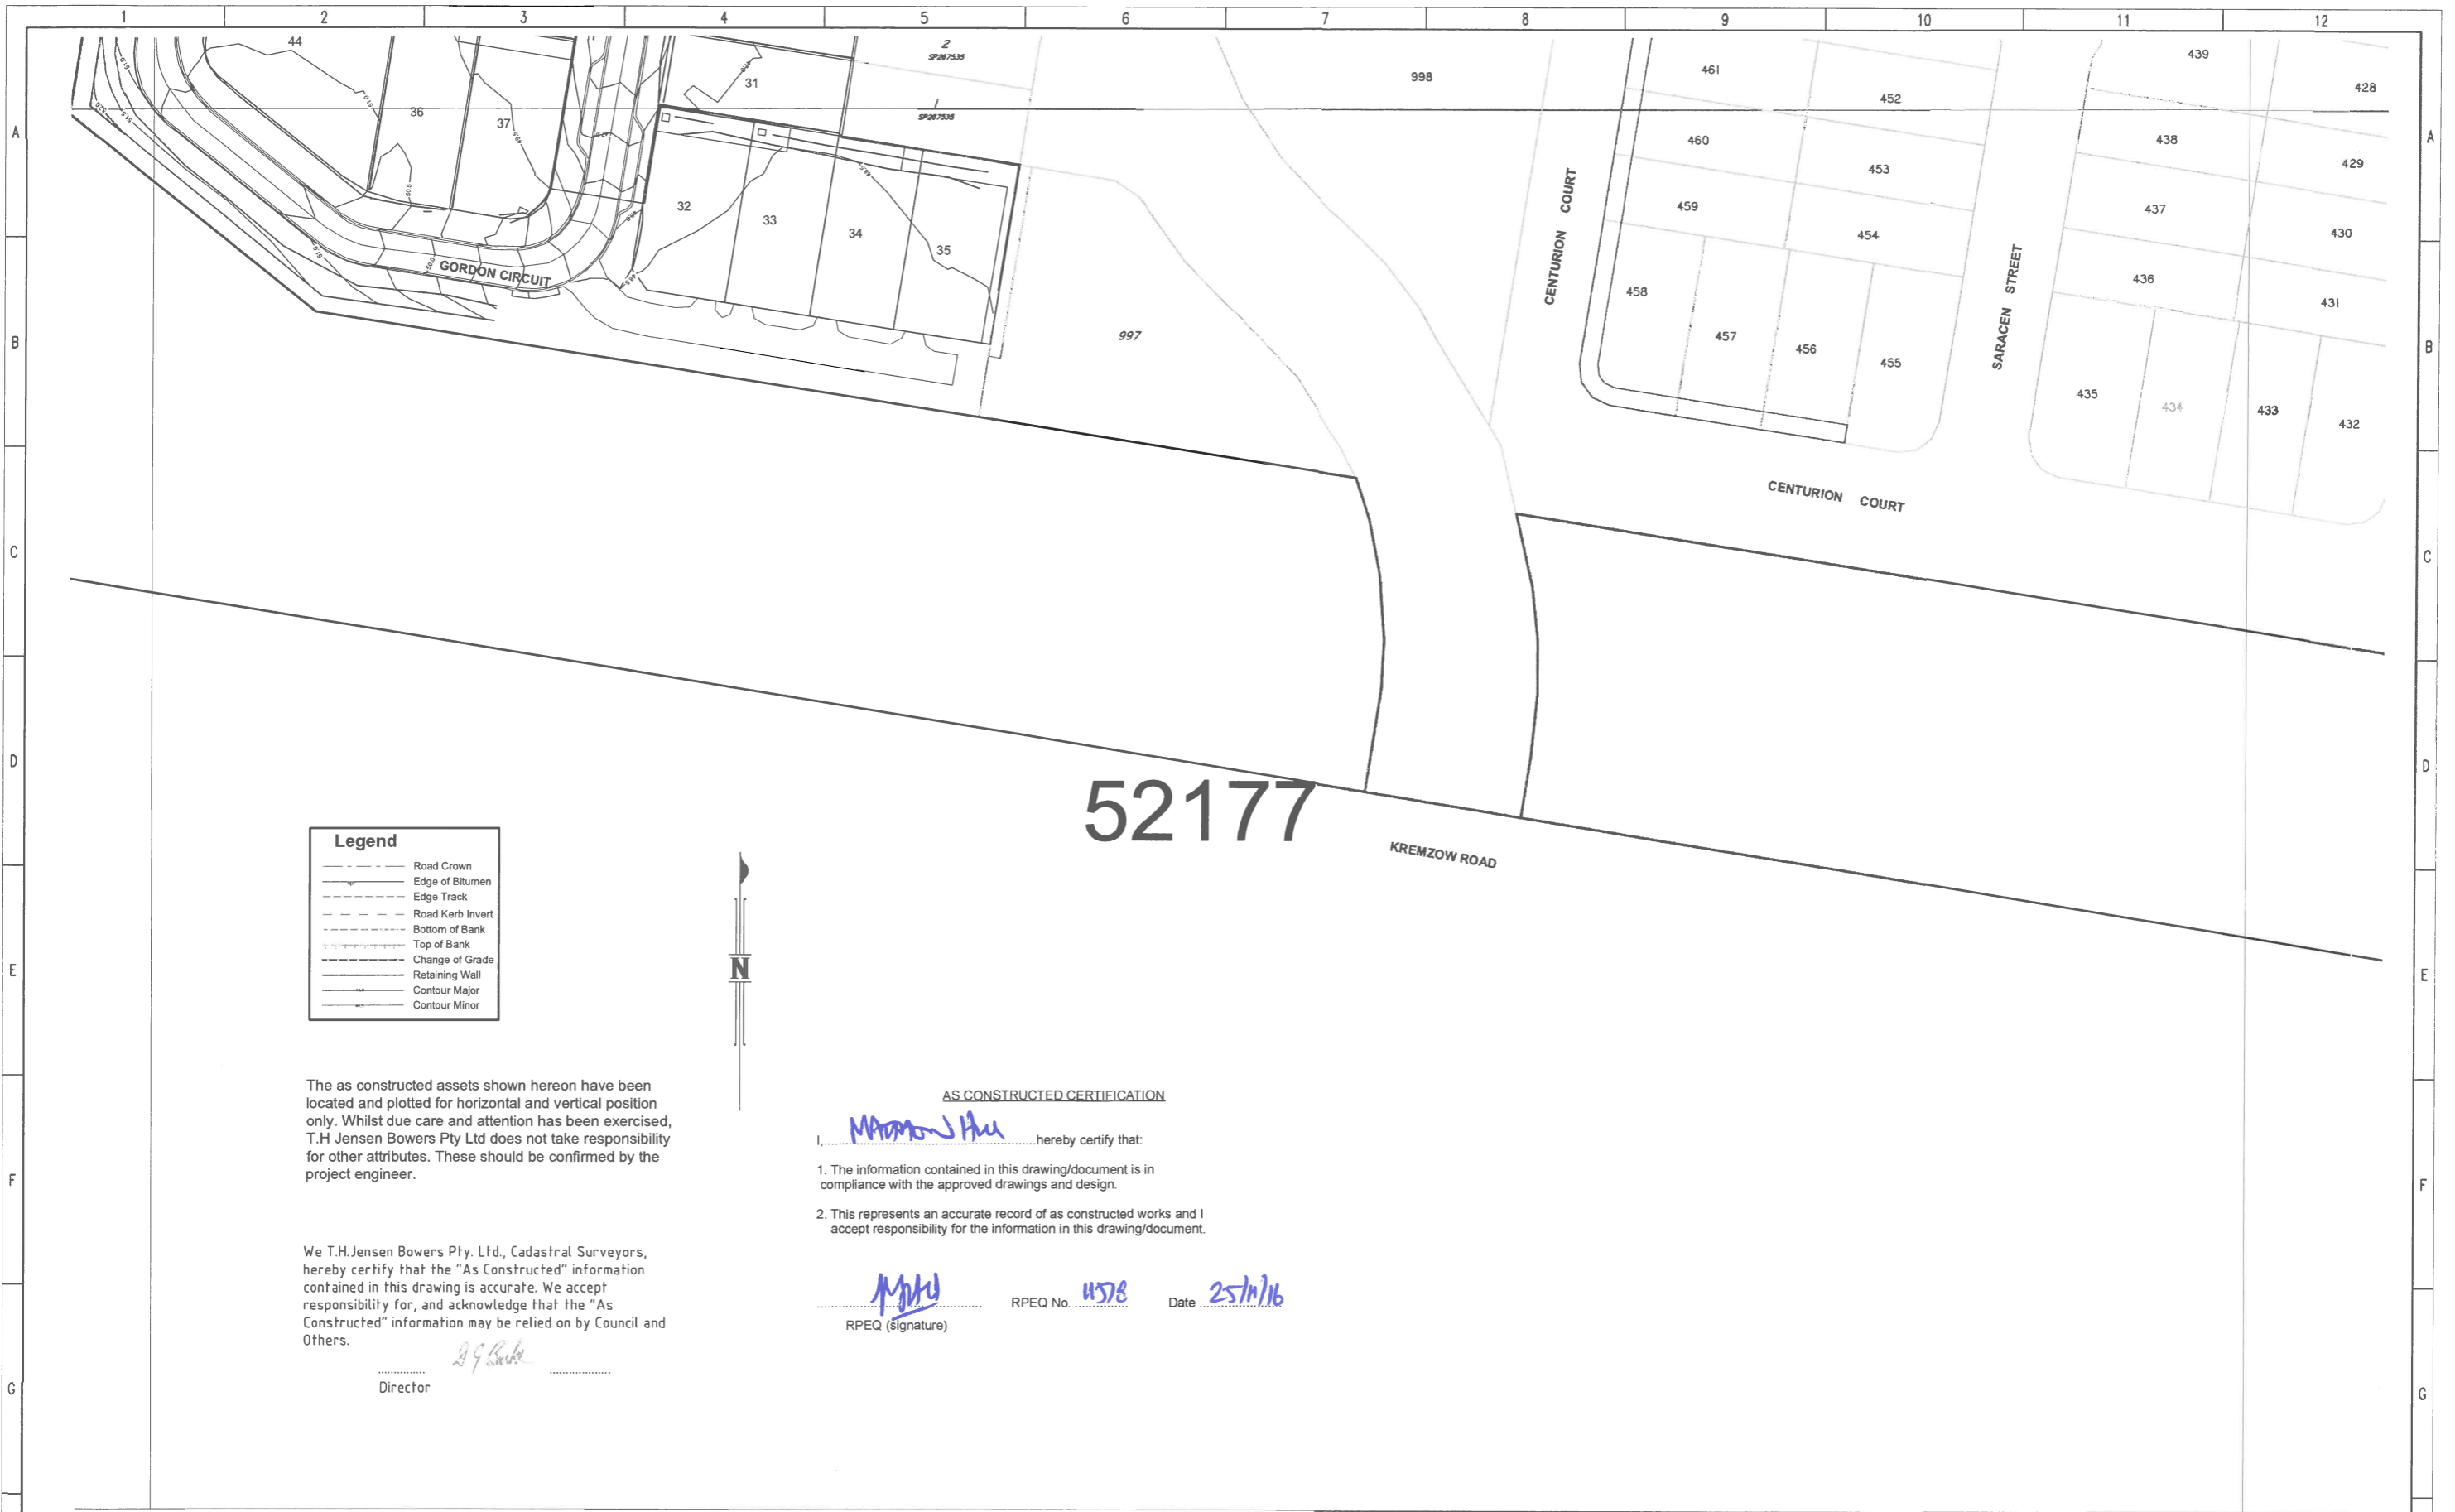

Legend	
	Road Crown
	Edge of Bitumen
	Edge Track
	Road Kerb Invert
	Bottom of Bank
	Top of Bank
	Change of Grade
	Retaining Wall
	Contour Major
	Contour Minor



The as constructed assets shown hereon have been located and plotted for horizontal and vertical position only. Whilst due care and attention has been exercised, T.H Jensen Bowers Pty Ltd does not take responsibility for other attributes. These should be confirmed by the project engineer.

We T.H Jensen Bowers Pty. Ltd., Cadastral Surveyors, hereby certify that the "As Constructed" information contained in this drawing is accurate. We accept responsibility for, and acknowledge that the "As Constructed" information may be relied on by Council and Others.

D. J. Burke
Director

AS CONSTRUCTED CERTIFICATION

I, *M. J. Au*, hereby certify that:

- The information contained in this drawing/document is in compliance with the approved drawings and design.
- This represents an accurate record of as constructed works and I accept responsibility for the information in this drawing/document.

M. J. Au RPEQ No. *4578* Date *25/11/16*
RPEQ (signature)

DRAWING REVISIONS		REFERENCE DRAWINGS		DESIGN FILE No.	DESIGNED	THIS WORK WAS PREPARED BY: DEFENCE HOUSING AUSTRALIA		MORETON BAY REGIONAL COUNCIL CABOOLTURE DISTRICT OFFICE 2 HASKING STREET CABOOLTURE QLD 4510 PO BOX 159 CABOOLTURE QLD 4510 Telephone: (07) 5433 0100 Fax: (07) 5433 4000	WARNER SPRINGS ESTATE Kremzow Road, Warner Stage 3 'AS CONSTRUCTED' - FINISHED SURFACE	MBRC SUBDIVISION REFERENCE	
REV.	REVISION DESCRIPTION	DRG. No.	DESCRIPTION	CONSTRUCT. No.	DATE					DA/20033/2008/V4DU/11	REV.
				S-7433-512	JM	SCALE 1:500 ORIGINAL SIZE A1			No. 3 OF 3 PLANS ASCON GRID NUMBER 52177		
					DH						