

DRAWING REVISIONS		REFERENCE DRAWINGS		DESIGN FILE No.	DESIGNED	THIS WORK WAS PREPARED BY: DEFENCE HOUSING AUSTRALIA			MORETON BAY REGIONAL COUNCIL CABOOLTURE DISTRICT OFFICE 2 HASKING STREET CABOOLTURE QLD 4510 PO BOX 159 CABOOLTURE QLD 4510 Telephone: (07) 5433 0100 Fax: (07) 5433 4000	WARNER SPRINGS ESTATE Kremzow Road, Warner Stage 3 'AS CONSTRUCTED' - WATER	MBRC SUBDIVISION REFERENCE	
REV.	REVISION DESCRIPTION	DRG. No.	DESCRIPTION	CONSTRUCT. No.	DATE						MG	DA/20033/2008/V4DU/11
				S-7433-512	22/08/16	DH	SCALE 1:500	ORIGINAL SIZE A1			No. 1 OF 3 PLANS	
											ASCON GRID NUMBER	
											52009	



AS CONSTRUCTED CERTIFICATION

Matthew Hill hereby certify that:

- The information contained in this drawing/document is in compliance with the approved drawings and design.
- This represents an accurate record of as constructed works and I accept responsibility for the information in this drawing/document.

M Hill RPEQ No. 11578 Date 22/11/16
RPEQ (signature)

We T.H.Jensen Bowers Pty. Ltd., Cadastral Surveyors, hereby certify that the "As Constructed" information contained in this drawing is accurate. We accept responsibility for, and acknowledge that the "As Constructed" information may be relied on by Council and Others.

S G Baker
Director

The as constructed assets shown hereon have been located and plotted for horizontal and vertical position only. Whilst due care and attention has been exercised, T.H.Jensen Bowers Pty Ltd does not take responsibility for other attributes. These should be confirmed by the project engineer.

LEGEND

- ∅ Pipe Diameter
- ⊙ Fire Hydrant
- Ready Tap
- Bend
- ∇ Valve
- ⊞ Water Meter
- Water Crossing
- T T Junction
- R Reducer

NOTES

All water main pipes are uPVC Class 16 unless otherwise stated
 All water service pipes are Ø25 PE-100 Class PN16
 All water conduit pipes are Ø100 uPVC Class 2D

52010

DRAWING REVISIONS		REFERENCE DRAWINGS		DESIGN FILE No.	DESIGNED
REV.	REVISION DESCRIPTION	DRG. No.	DESCRIPTION	CONSTRUCT. No.	DATE
				SURVEY FILE No. S-7433-512 <td>DRAWN MG</td>	DRAWN MG
				FIELD BOOK <td>DATE 21/01/16</td>	DATE 21/01/16
				LOG BOOK <td>CHECKED DH</td>	CHECKED DH
				LEVEL DATUM PMS7810 (RL:47.338m) <td>DATE</td>	DATE
				DATUM MGA Zone 56	

THIS WORK WAS PREPARED BY:
DEFENCE HOUSING AUSTRALIA




MORETON BAY REGIONAL COUNCIL
 CABOOLTURE DISTRICT OFFICE
 2 HASKING STREET CABOOLTURE QLD 4510
 PO BOX 159 CABOOLTURE QLD 4510
 Telephone: (07) 5433 0100
 Fax: (07) 5433 4000

WARNER SPRINGS ESTATE
 Krenzow Road, Warner
 Stage 3

MBRC SUBDIVISION REFERENCE	
DA/20033/2008/V4DU/11	
No. 2 OF 3 PLANS	
ASCON GRID NUMBER	REV.
52010	

SCALE 1:500 ORIGINAL SIZE A1

'AS CONSTRUCTED' - WATER

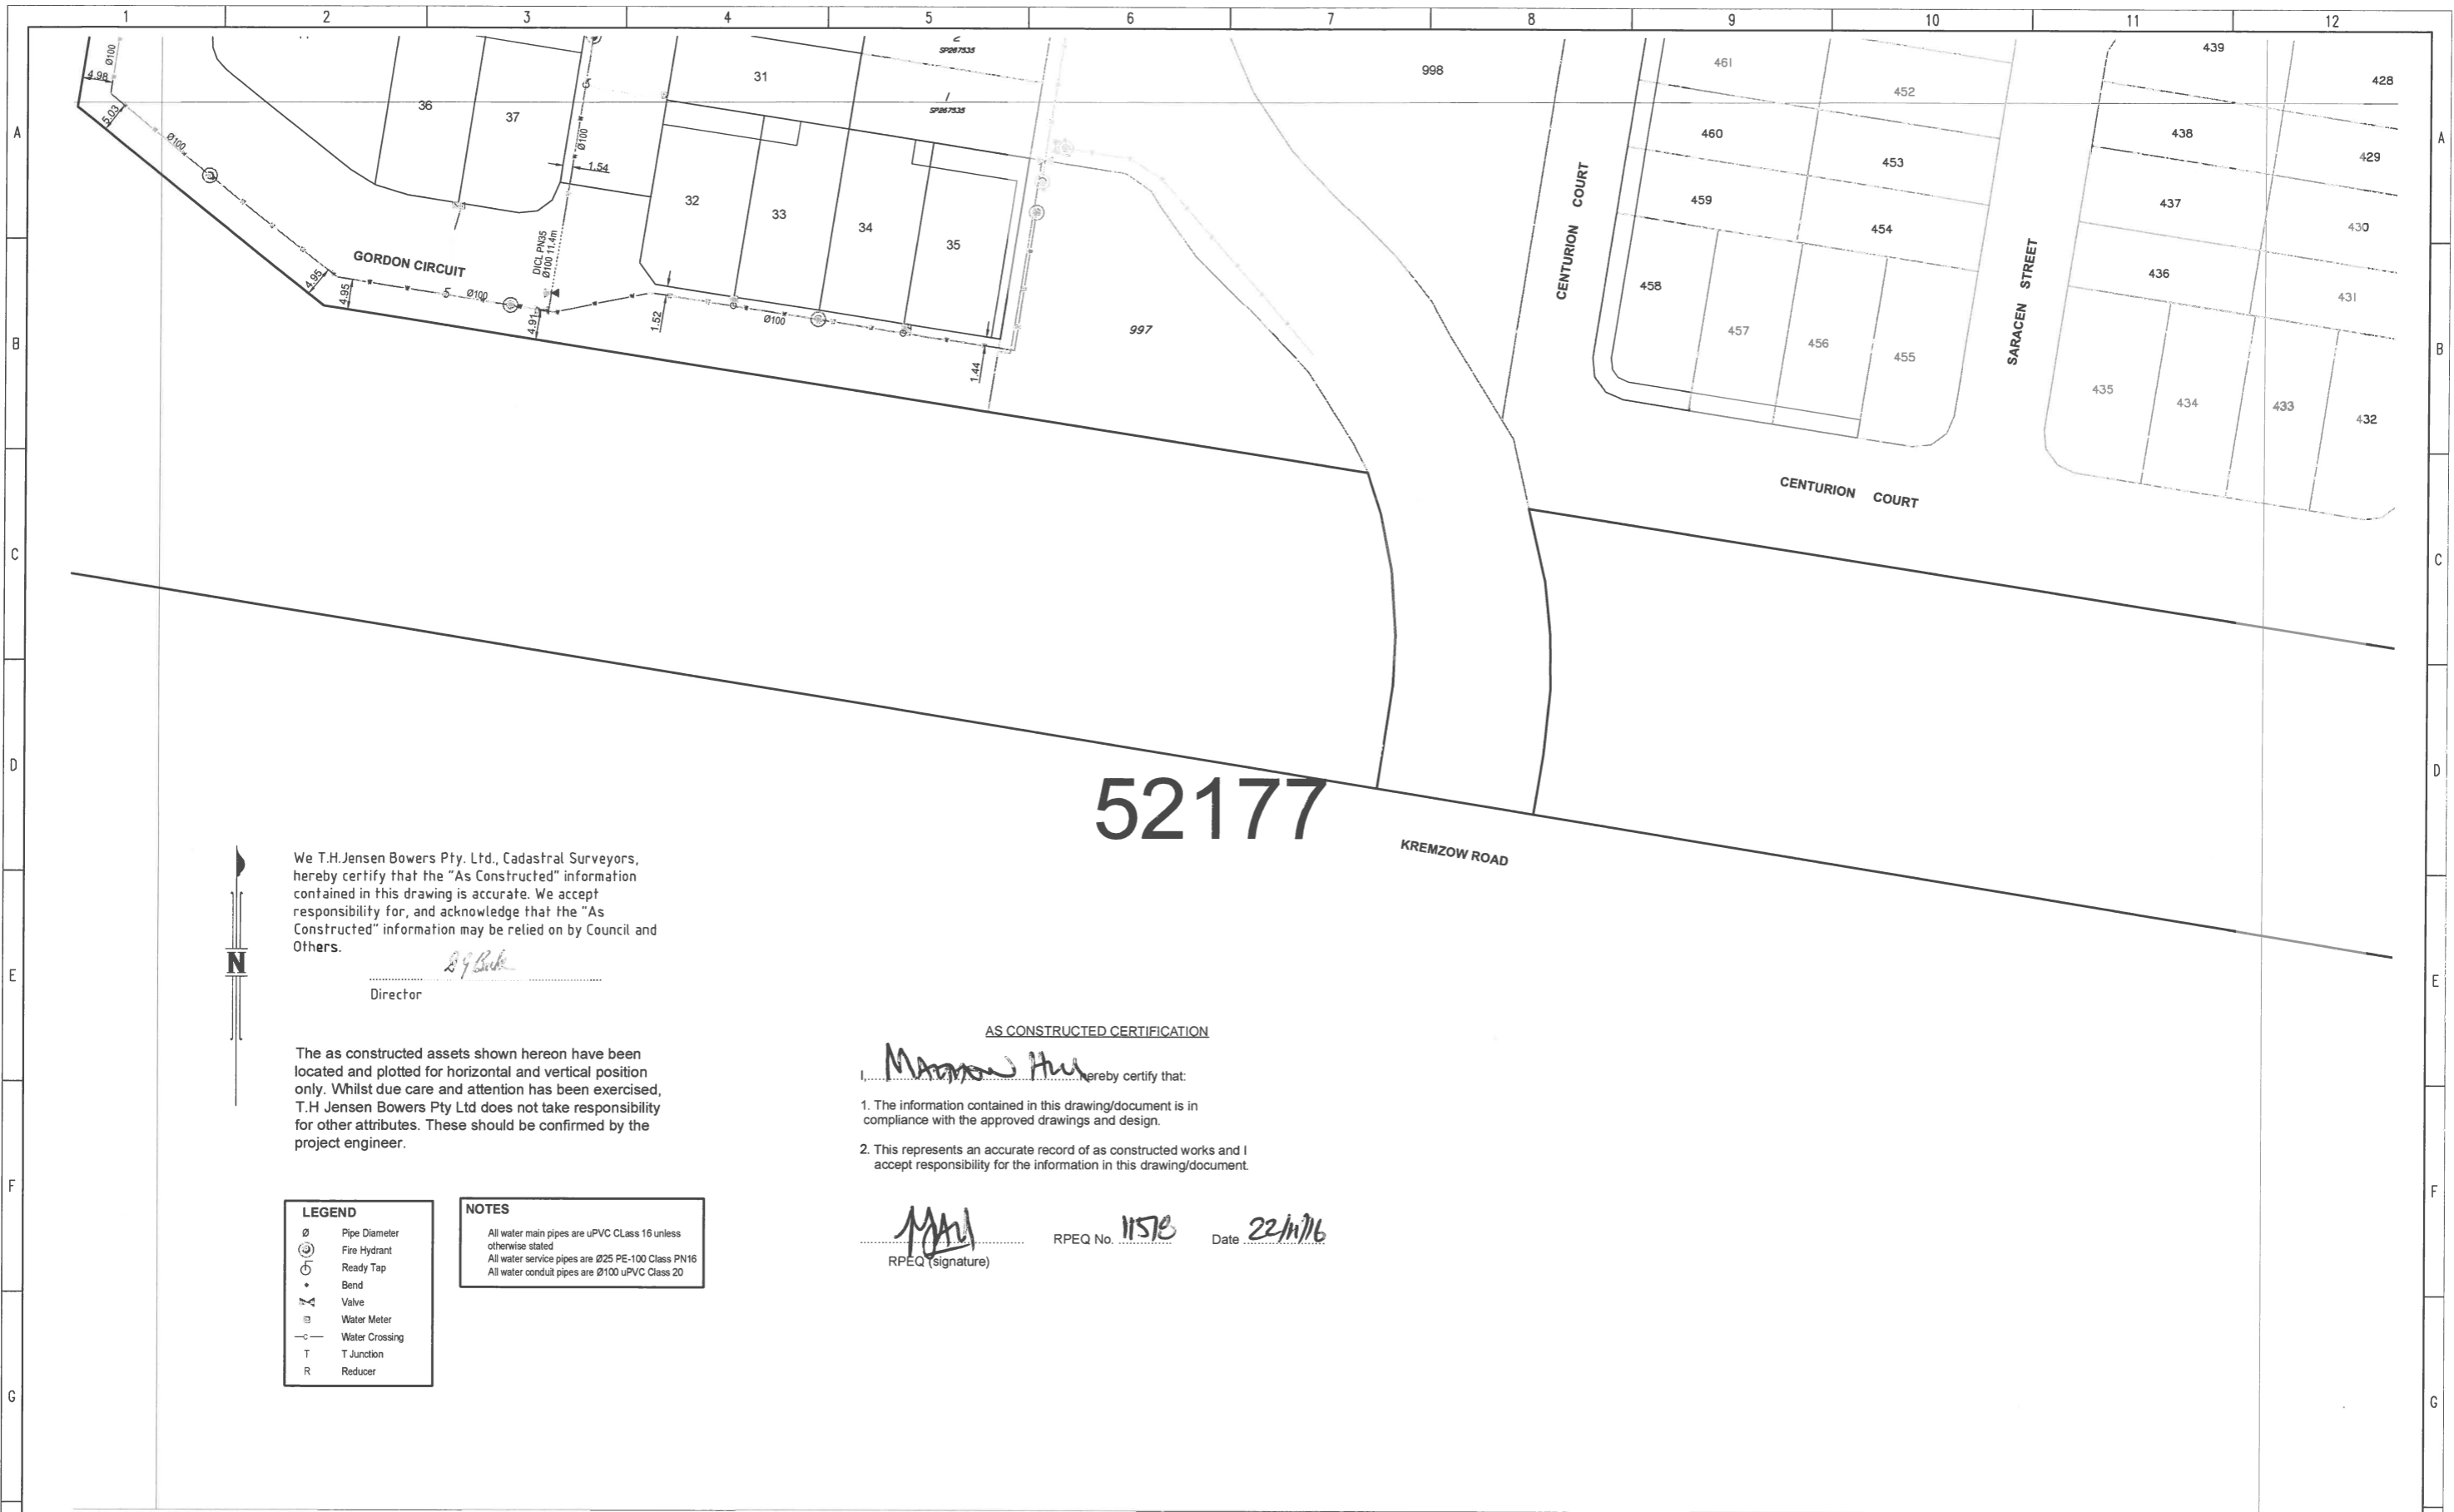

We T.H.Jensen Bowers Pty. Ltd., Cadastral Surveyors, hereby certify that the "As Constructed" information contained in this drawing is accurate. We accept responsibility for, and acknowledge that the "As Constructed" information may be relied on by Council and Others.



[Signature]
Director

The as constructed assets shown hereon have been located and plotted for horizontal and vertical position only. Whilst due care and attention has been exercised, T.H.Jensen Bowers Pty Ltd does not take responsibility for other attributes. These should be confirmed by the project engineer.

AS CONSTRUCTED CERTIFICATION

I, *[Signature]* hereby certify that:

1. The information contained in this drawing/document is in compliance with the approved drawings and design.
2. This represents an accurate record of as constructed works and I accept responsibility for the information in this drawing/document.

[Signature] RPEQ No. 11578 Date 22/1/16
RPEQ (signature)

LEGEND

∅	Pipe Diameter
⊙	Fire Hydrant
⊕	Ready Tap
•	Bend
∩	Valve
⊞	Water Meter
—	Water Crossing
T	T Junction
R	Reducer

NOTES

All water main pipes are uPVC Class 16 unless otherwise stated
All water service pipes are Ø25 PE-100 Class PN16
All water conduit pipes are Ø100 uPVC Class 20

DRAWING REVISIONS		REFERENCE DRAWINGS		DESIGN FILE No.	DESIGNED
REV.	REVISION DESCRIPTION	DRG. No.	DESCRIPTION	CONSTRUCT. No.	DATE
				S-7433-512	DRAWN MG
					DATE 21/01/16
					CHECKED DH
					DATE
				PMS7810 (R.47.338m)	
				DATUM MGA Zone 56	

THIS WORK WAS PREPARED BY:
DEFENCE HOUSING AUSTRALIA

SCALE 1:500 ORIGINAL SIZE A1

Moreton Bay
Regional Council

MORETON BAY REGIONAL COUNCIL
CABOOLTURE DISTRICT OFFICE
2 HASKING STREET CABOOLTURE QLD 4510
PO BOX 159 CABOOLTURE QLD 4510
Telephone: (07) 5433 0100
Fax: (07) 5433 4000

WARNER SPRINGS ESTATE
Kremzow Road, Warner
Stage 3

'AS CONSTRUCTED' - WATER

MBRC SUBDIVISION REFERENCE

DA/20033/2008/V4DU/11
No. 3 OF 3 PLANS
ASCEN GRID NUMBER
REV.
52177