



We T.H.Jensen Bowers Pty. Ltd., Cadastral Surveyors, hereby certify that the "As Constructed" information contained in this drawing is accurate. We accept responsibility for, and acknowledge that the "As Constructed" information may be relied on by Council and Others.

Director

Legend	
	Road Crown
	Edge of Bitumen
	Edge Track
	Road Kerb Invert
	Bottom of Bank
	Top of Bank
	Change of Grade
	Retaining Wall
	Contour Major
	Contour Minor

CONSULTING ENGINEER'S CERTIFICATION

I, _____ (Name) (RPEQ)
 being a Certified/Registered Engineer & duly authorised of
 _____ BROWN CONSULTING PTY LTD _____
 (Consulting firm or company)

hereby:-

- certify that the information in this drawing is an accurate "as constructed" representation of the works.
- accept responsibility for the 'as constructed' information contained in this drawing
- acknowledge the 'as constructed' information contained in this drawing may be relied on by Council and others.

Certification for stage _____ by _____ on _____
 (stage no.) (signature) (date)
 for _____ BROWN CONSULTING PTY LTD _____
 (Consulting firm or company)

DRAWING REVISIONS		REFERENCE DRAWINGS		DESIGN FILE No.	DESIGNED
REV.	REVISION DESCRIPTION	DRG. No.	DESCRIPTION	CONSTRUCT. No.	DATE
				SURVEY FILE No. S-7433-194	DRAWN PW
				FIELD BOOK	DATE 11/7/14
				LOG BOOK	CHECKED JR
				LEVEL DATUM PH57810 (RL47.338m)	DATE Date
				DATUM MGA Zone 56	

THIS WORK WAS PREPARED BY:
DEFENCE HOUSING AUSTRALIA

SCALE 1:500 ORIGINAL SIZE A1


Moreton Bay
 Regional Council

MORETON BAY REGIONAL COUNCIL
 CABOOLTURE DISTRICT OFFICE
 2 HASKING STREET CABOOLTURE QLD 4510
 PO BOX 159 CABOOLTURE QLD 4510
 Telephone: (07) 5433 0100
 Fax: (07) 5433 4000

WARNER SPRINGS ESTATE
 Kremzow Road, Warner
 Stage 2

'AS CONSTRUCTED' - FINISHED SURFACE

MERC SUBDIVISION REFERENCE	
Development No.	
No. 1 OF 2 PLANS	
ASCON GRID NUMBER	REV.
51842	

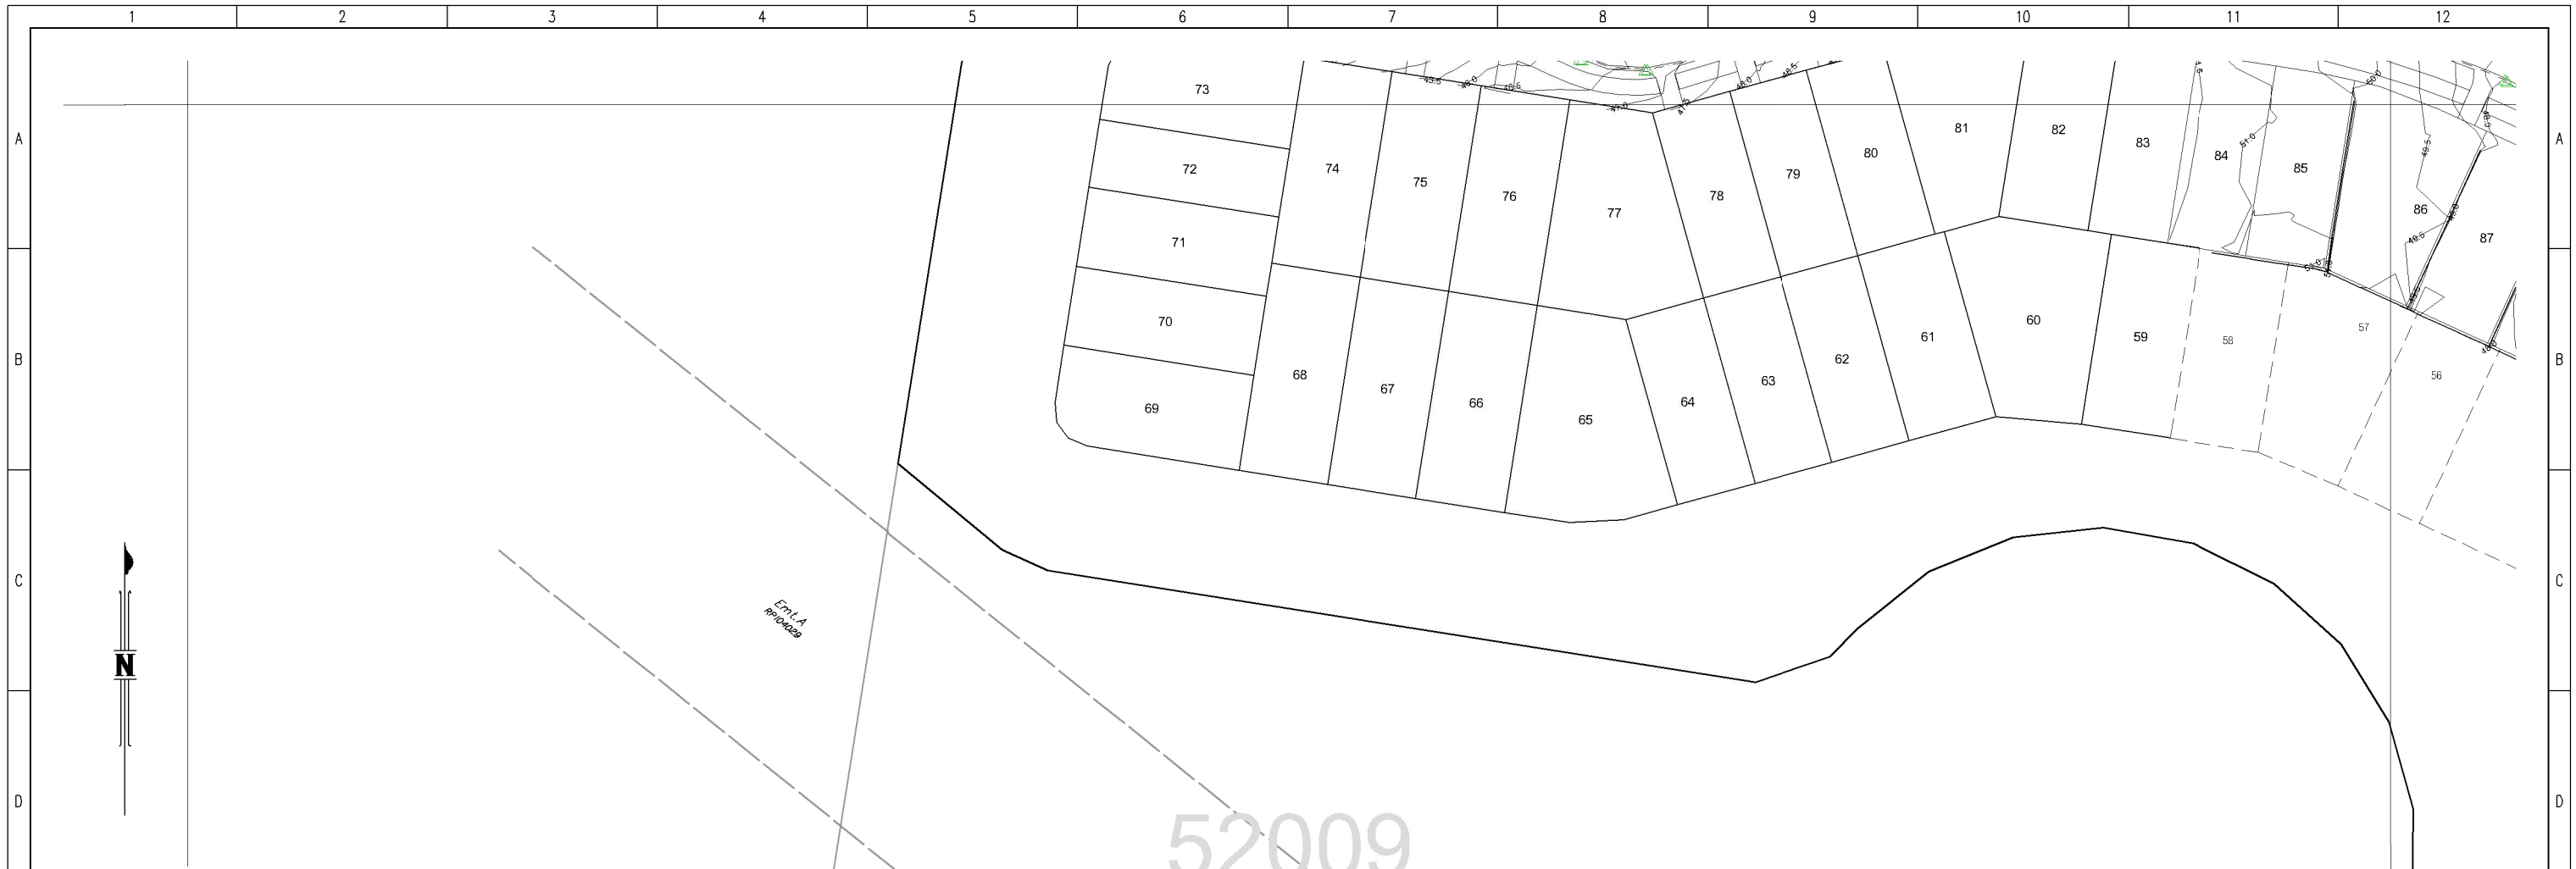

We T.H.Jensen Bowers Pty. Ltd., Cadastral Surveyors, hereby certify that the "As Constructed" information contained in this drawing is accurate. We accept responsibility for, and acknowledge that the "As Constructed" information may be relied on by Council and Others.

Director

Legend	
	Road Crown
	Edge of Bitumen
	Edge Track
	Road Kerb Invert
	Bottom of Bank
	Top of Bank
	Change of Grade
	Retaining Wall
	Contour Major
	Contour Minor

CONSULTING ENGINEER'S CERTIFICATION

I, (Name) (RPEQ) being a Certified/Registered Engineer & duly authorised ofBROWN CONSULTING PTY LTD..... (Consulting firm or company) hereby:-

- certify that the information in this drawing is an accurate "as constructed" representation of the works.
- accept responsibility for the 'as constructed' information contained in this drawing
- acknowledge the 'as constructed' information contained in this drawing may be relied on by Council and others.

Certification for stage by on (stage no.) (signature) (date) forBROWN CONSULTING PTY LTD..... (Consulting firm or company)

DRAWING REVISIONS		REFERENCE DRAWINGS		DESIGN FILE No.	DESIGNED
REV.	REVISION DESCRIPTION	DRG. No.	DESCRIPTION	CONSTRUCT. No.	DATE
				S-7433-194	DRAWN PW
					DATE 11/7/14
					CHECKED JR
					DATE

THIS WORK WAS PREPARED BY:
DEFENCE HOUSING AUSTRALIA

SCALE 1:500 ORIGINAL SIZE A1

MORETON BAY REGIONAL COUNCIL
 CABOOLTURE DISTRICT OFFICE
 2 HASKING STREET CABOOLTURE QLD 4510
 PO BOX 159 CABOOLTURE QLD 4510
 Telephone: (07) 5433 0100
 Fax: (07) 5433 4000

WARNER SPRINGS ESTATE
 Kremzow Road, Warner
 Stage 2

'AS CONSTRUCTED' - FINISHED SURFACE

MIRC SUBDIVISION REFERENCE	
Development No.	
No. 2 OF 2 PLANS	
ASCAN GRID NUMBER	REV.
52009	