

We T.H.Jensen Bowers Pty. Ltd., Cadastral Surveyors, hereby certify that the "As Constructed" information contained in this drawing is accurate. We accept responsibility for, and acknowledge that the "As Constructed" information may be relied on by Council and Others.

Director

LEGEND	
∅	Pipe Diameter
⊙	Fire Hydrant
●	Ready Tap
•	Bend
⋈	Valve
⊠	Water Meter
—	Water Crossing
T	T Junction
R	Reducer
—	New Water Service point of entry (indicative only)

**CONSULTING ENGINEER'S CERTIFICATION**

I ..... (Name) (RPEQ)  
 being a Certified/Registered Engineer & duly authorised of  
 .....BROWN CONSULTING PTY LTD.....  
 (Consulting firm or company)

hereby:-

- certify that the information in this drawing is an accurate "as constructed" representation of the works.
- accept responsibility for the 'as constructed' information contained in this drawing
- acknowledge the 'as constructed' information contained in this drawing may be relied on by Council and others.

Certification for stage ..... by ..... on .....  
 (stage no.) (signature) (date)  
 for .....BROWN CONSULTING PTY LTD.....  
 (Consulting firm or company)

DRAWING REVISIONS		REFERENCE DRAWINGS		DESIGN FILE No.	DESIGNED
REV.	REVISION DESCRIPTION	DRG. No.	DESCRIPTION	CONSTRUCT. No.	DATE
				SURVEY FILE No. S-7433-???	DRAWN PW
				FIELD BOOK	DATE 11/7/14
				LOG BOOK	CHECKED JR
				LEVEL DATUM PMS7810 (RL47.338m)	DATE Date
				DATUM MGA Zone 56	

**THIS WORK WAS PREPARED BY:**  
**DEFENCE HOUSING AUSTRALIA**

SCALE 1:500 ORIGINAL SIZE A1




MORETON BAY REGIONAL COUNCIL  
 CABOOLTURE DISTRICT OFFICE  
 2 HASKING STREET CABOOLTURE QLD 4510  
 PO BOX 159 CABOOLTURE QLD 4510  
 Telephone: (07) 5433 0100  
 Fax: (07) 5433 4000

**WARNER SPRINGS ESTATE**  
 Kremzow Road, Warner  
 Stage 2

'AS CONSTRUCTED' - WATER

MBRC SUBDIVISION REFERENCE	
Development No.	
No. 1 OF 4 PLANS	
ASCON GRID NUMBER	REV.
51508	

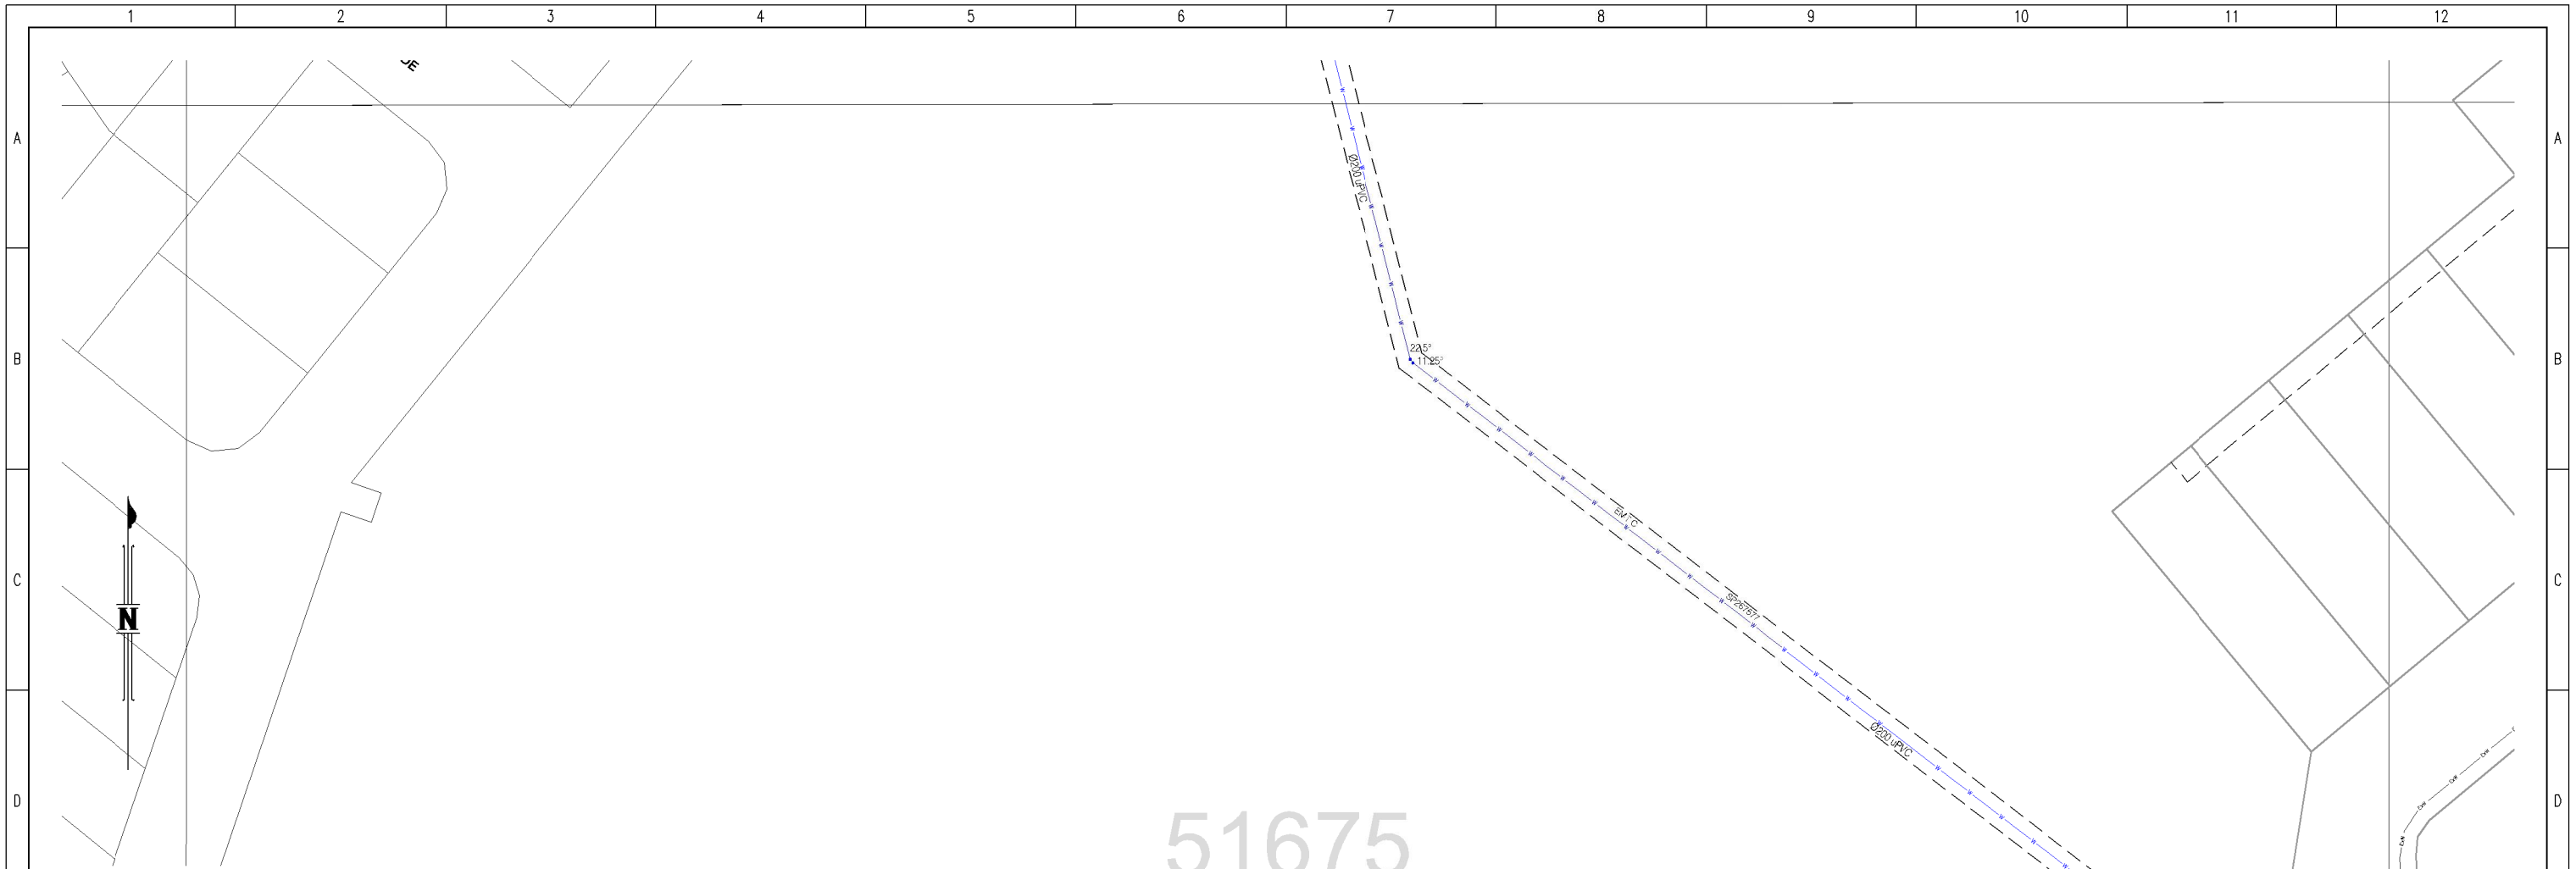

We T.H.Jensen Bowers Pty. Ltd., Cadastral Surveyors, hereby certify that the "As Constructed" information contained in this drawing is accurate. We accept responsibility for, and acknowledge that the "As Constructed" information may be relied on by Council and Others.

Director

LEGEND	
Ø	Pipe Diameter
●	Fire Hydrant
●	Ready Tap
•	Bend
⊕	Valve
⊞	Water Meter
—	Water Crossing
T	T Junction
R	Reducer
New Water Service point of entry (indicative only)	

**CONSULTING ENGINEER'S CERTIFICATION**

I ..... (Name) (RPEQ)  
 being a Certified/Registered Engineer & duly authorised of  
 .....BROWN CONSULTING PTY LTD.....  
 (Consulting firm or company)

- hereby:-
- certify that the information in this drawing is an accurate "as constructed" representation of the works.
  - accept responsibility for the 'as constructed' information contained in this drawing
  - acknowledge the 'as constructed' information contained in this drawing may be relied on by Council and others.

Certification for stage ..... by ..... on .....  
 (stage no.) (signature) (date)  
 for .....BROWN CONSULTING PTY LTD.....  
 (Consulting firm or company)

DRAWING REVISIONS		REFERENCE DRAWINGS		DESIGN FILE No.	DESIGNED
REV.	REVISION DESCRIPTION	DRG. No.	DESCRIPTION	CONSTRUCT. No.	DATE
				S-7433-???	DRAWN PW
					DATE 11/7/14
					CHECKED JR
					DATE
					DATE

**THIS WORK WAS PREPARED BY:**  
**DEFENCE HOUSING AUSTRALIA**


SCALE 1:500 ORIGINAL SIZE A1



MORETON BAY REGIONAL COUNCIL  
 CABOOLTURE DISTRICT OFFICE  
 2 HASKING STREET CABOOLTURE QLD 4510  
 PO BOX 159 CABOOLTURE QLD 4510  
 Telephone: (07) 5433 0100  
 Fax: (07) 5433 4000

**WARNER SPRINGS ESTATE**  
 Kremzow Road, Warner  
 Stage 2  
 'AS CONSTRUCTED' - WATER


MBRC SUBDIVISION REFERENCE	
Development No.	
No. 2 OF 4 PLANS	
ASCON GRID NUMBER	REV.
51675	

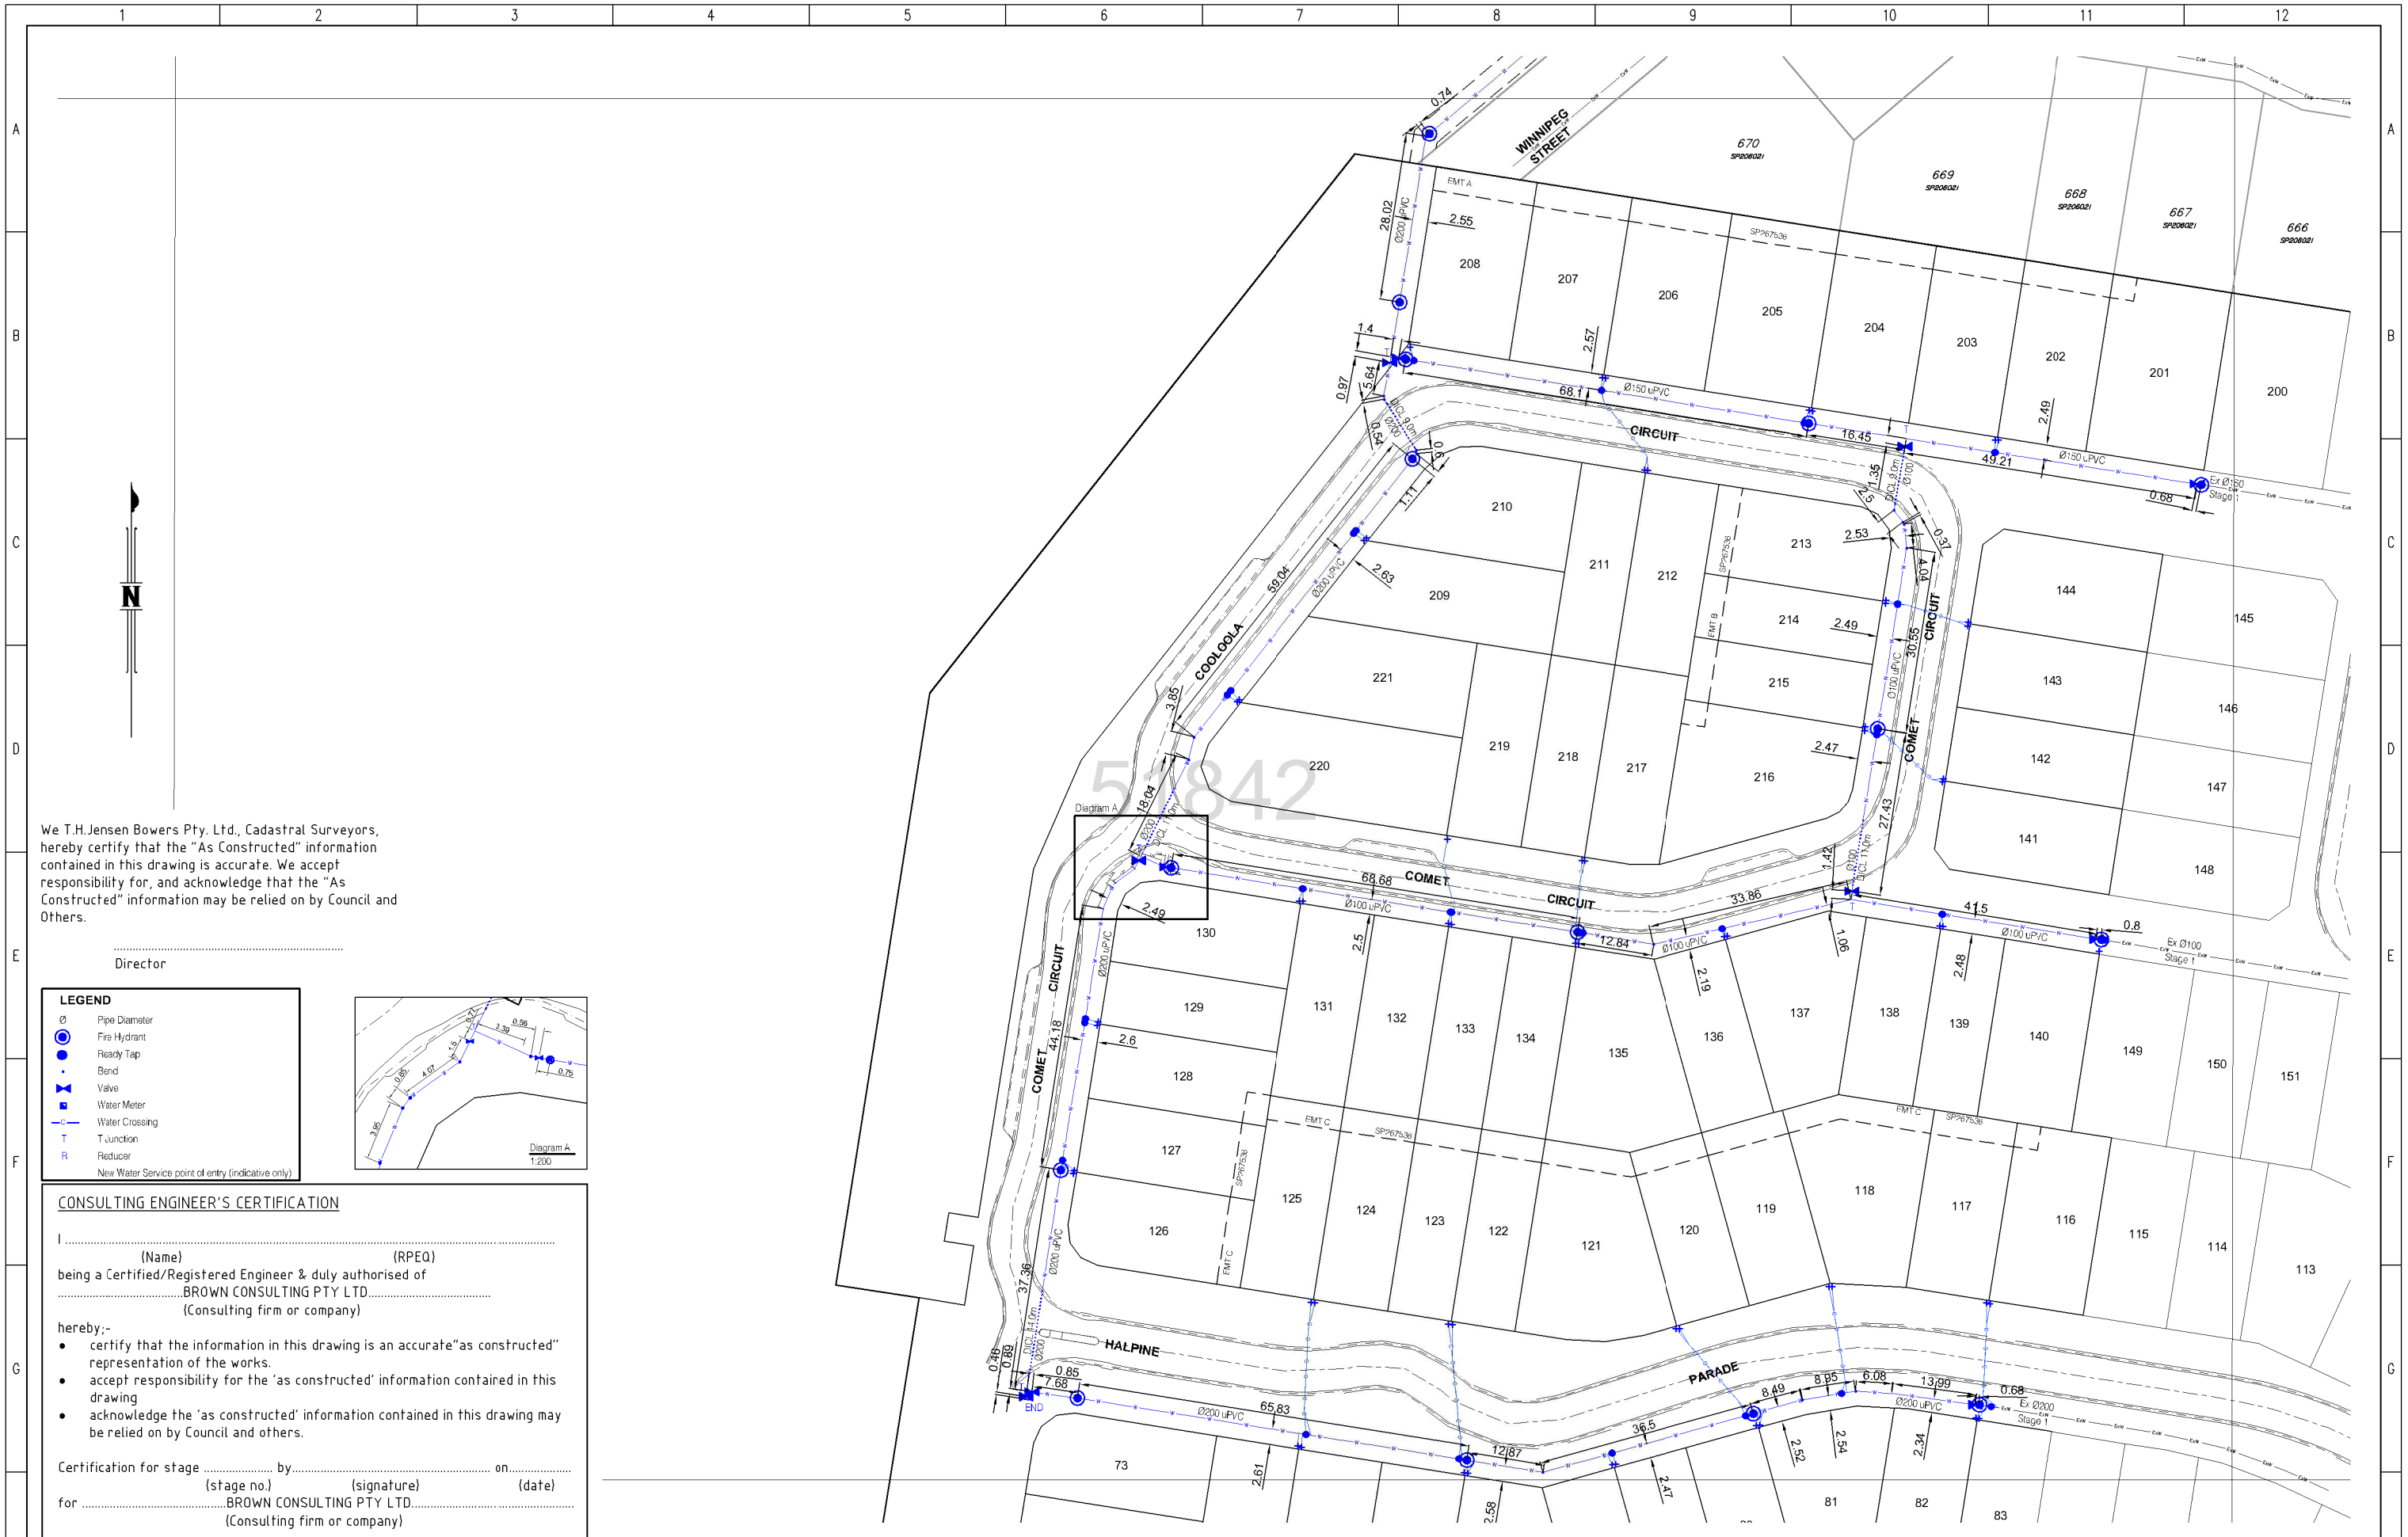

We T.H.Jensen Bowers Pty. Ltd., Cadastral Surveyors, hereby certify that the "As Constructed" information contained in this drawing is accurate. We accept responsibility for, and acknowledge that the "As Constructed" information may be relied on by Council and Others.

Director

LEGEND	
Ø	Pipe Diameter
●	Fire Hydrant
●	Ready Tap
○	Bend
⊕	Valve
⊗	Water Meter
—	Water Crossing
T	T Junction
R	Reducer
—	New Water Service point of entry (indicative only)

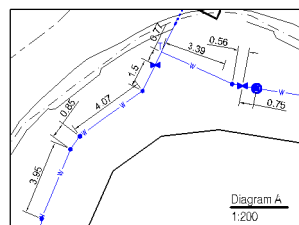

**CONSULTING ENGINEER'S CERTIFICATION**

I, \_\_\_\_\_ (Name) \_\_\_\_\_ (RPEQ)  
 being a Certified/Registered Engineer & duly authorised of  
 \_\_\_\_\_ BROWN CONSULTING PTY LTD \_\_\_\_\_  
 (Consulting firm or company)

hereby:-

- certify that the information in this drawing is an accurate "as constructed" representation of the works.
- accept responsibility for the 'as constructed' information contained in this drawing
- acknowledge the 'as constructed' information contained in this drawing may be relied on by Council and others.

Certification for stage \_\_\_\_\_ by \_\_\_\_\_ on \_\_\_\_\_  
 (stage no.) (signature) (date)  
 for \_\_\_\_\_ BROWN CONSULTING PTY LTD \_\_\_\_\_  
 (Consulting firm or company)

DRAWING REVISIONS		REFERENCE DRAWINGS		DESIGN FILE No.	DESIGNED
REV.	REVISION DESCRIPTION	DRG. No.	DESCRIPTION	CONSTRUCT. No.	DATE

**THIS WORK WAS PREPARED BY:**  
**DEFENCE HOUSING AUSTRALIA**

SCALE 1:500 ORIGINAL SIZE A1


**Moreton Bay**  
 Regional Council

MORETON BAY REGIONAL COUNCIL  
 CABOOLTURE DISTRICT OFFICE  
 2 HASKING STREET CABOOLTURE QLD 4510  
 PO BOX 159 CABOOLTURE QLD 4510  
 Telephone: (07) 5433 0100  
 Fax: (07) 5433 4000

**WARNER SPRINGS ESTATE**  
 Kremzow Road, Warner  
 Stage 2

'AS CONSTRUCTED' - WATER

MBRC SUBDIVISION REFERENCE	
Development No.	
No. 3 OF 4 PLANS	
ASCON GRID NUMBER	REV.
51842	

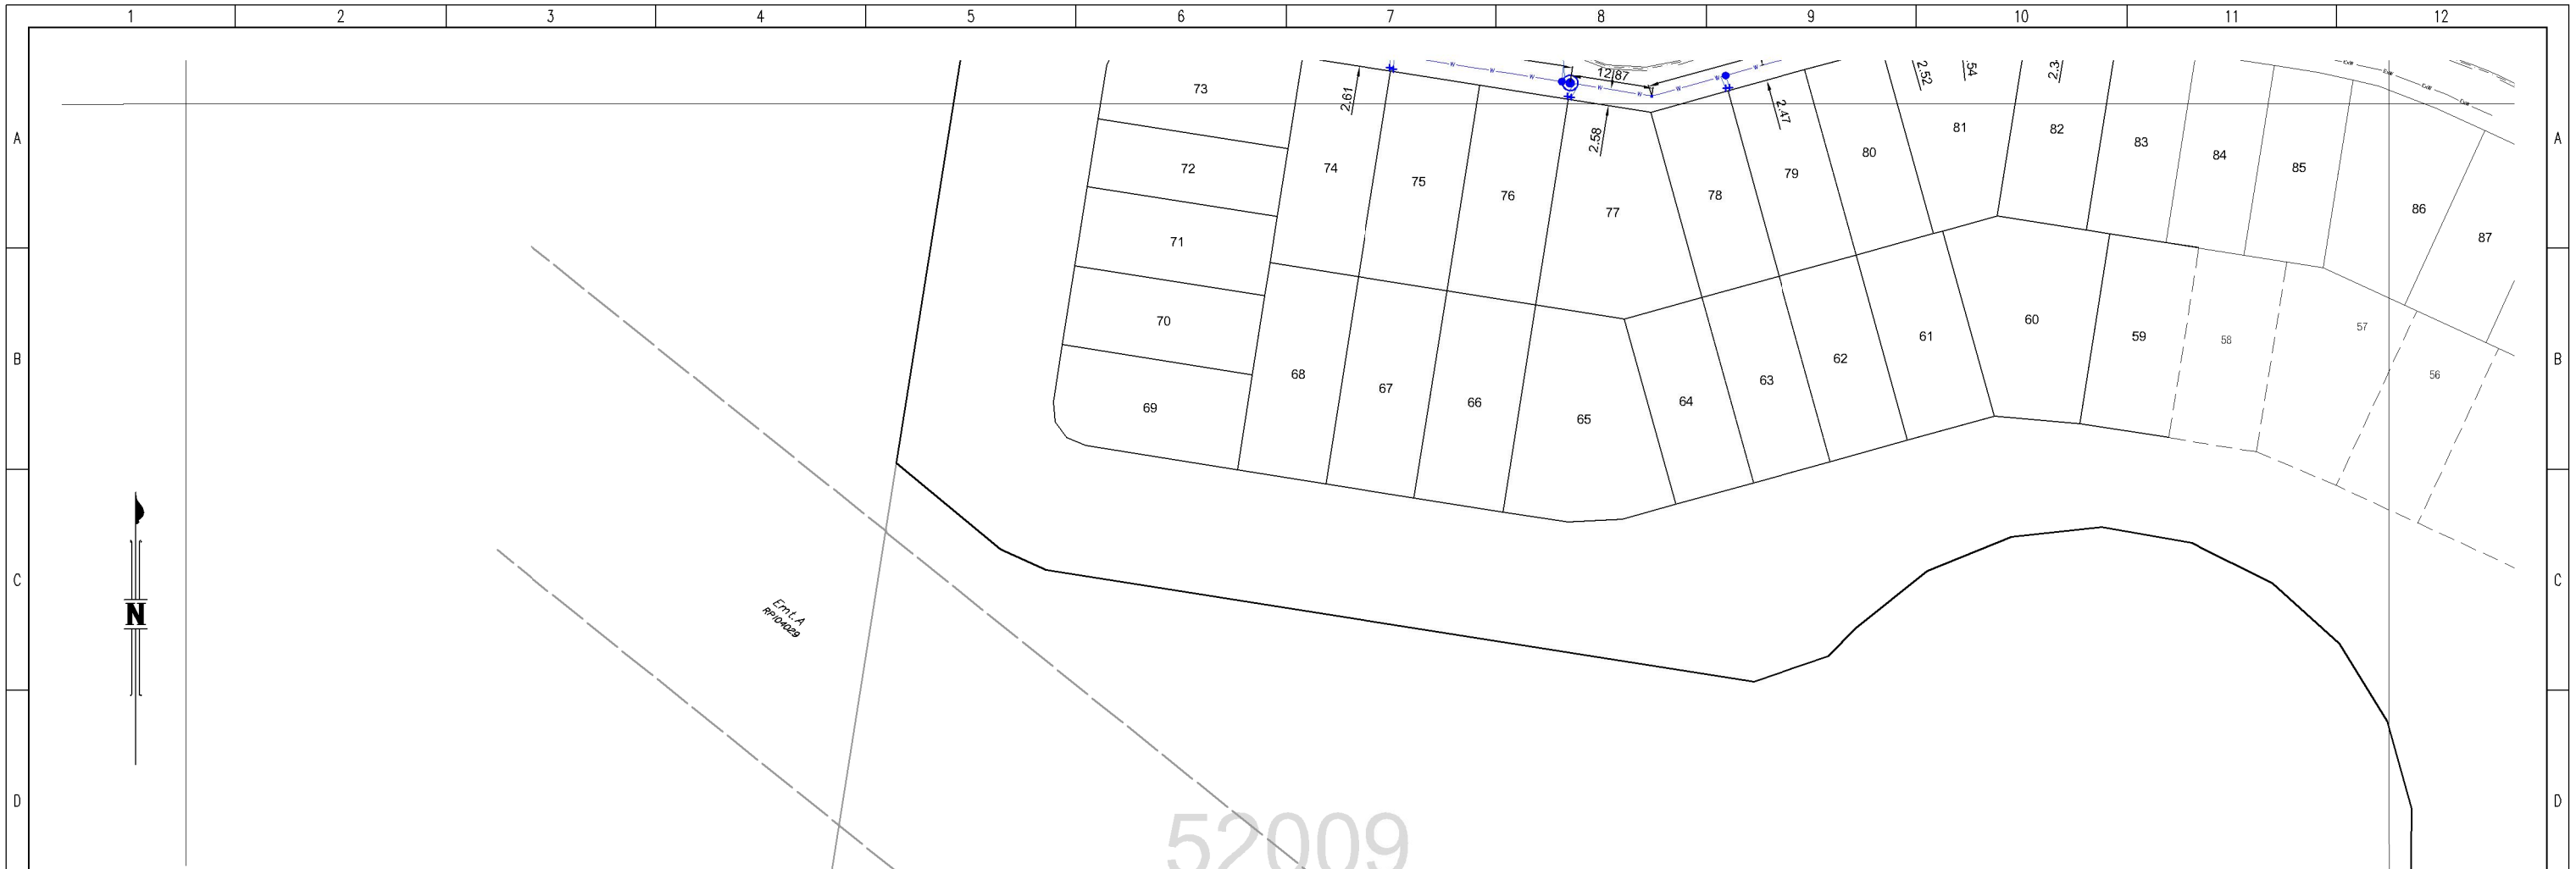

We T.H.Jensen Bowers Pty. Ltd., Cadastral Surveyors, hereby certify that the "As Constructed" information contained in this drawing is accurate. We accept responsibility for, and acknowledge that the "As Constructed" information may be relied on by Council and Others.

Director

LEGEND	
∅	Pipe Diameter
⊙	Fire Hydrant
●	Ready Tap
•	Bend
⋈	Valve
⊠	Water Meter
—C—	Water Crossing
T	T Junction
R	Reducer
New Water Service point of entry (indicative only)	

**CONSULTING ENGINEER'S CERTIFICATION**

I ..... (Name) ..... (RPEQ)  
 being a Certified/Registered Engineer & duly authorised of  
 .....BROWN CONSULTING PTY LTD.....  
 (Consulting firm or company)

hereby:-

- certify that the information in this drawing is an accurate "as constructed" representation of the works.
- accept responsibility for the 'as constructed' information contained in this drawing
- acknowledge the 'as constructed' information contained in this drawing may be relied on by Council and others.

Certification for stage ..... by ..... on .....  
 (stage no.) (signature) (date)  
 for .....BROWN CONSULTING PTY LTD.....  
 (Consulting firm or company)

DRAWING REVISIONS		REFERENCE DRAWINGS		DESIGN FILE No.	DESIGNED
REV.	REVISION DESCRIPTION	DRG. No.	DESCRIPTION	CONSTRUCT. No.	DATE
				S-7433-???	DRAWN PW
					DATE 11/7/14
					CHECKED JR
					DATE
					DATE
					DATE

**THIS WORK WAS PREPARED BY:**  
**DEFENCE HOUSING AUSTRALIA**

SCALE 1:500 ORIGINAL SIZE A1

MORETON BAY REGIONAL COUNCIL  
 CABOOLTURE DISTRICT OFFICE  
 2 HASKING STREET CABOOLTURE QLD 4510  
 PO BOX 159 CABOOLTURE QLD 4510  
 Telephone: (07) 5433 0100  
 Fax: (07) 5433 4000

**WARNER SPRINGS ESTATE**  
 Kremzow Road, Warner  
 Stage 2

'AS CONSTRUCTED' - WATER

MBRC SUBDIVISION REFERENCE	
Development No.	
No. 4 OF 4 PLANS	
ASCON GRID NUMBER	REV.
52009	