

We T.H.Jensen Bowers Pty. Ltd., Cadastral Surveyors, hereby certify that the "As Constructed" information contained in this drawing is accurate. We accept responsibility for, and acknowledge that the "As Constructed" information may be relied on by Council and Others.

.....
Director

LEGEND	
∅	Pipe Diameter
●	Fire Hydrant
○	Ready Tap
•	Bend
⋈	Valve
■	Water Meter
—	Water Crossing
T	T Junction


CONSULTING ENGINEER'S CERTIFICATION

I
(Name) (RPEQ)
being a Certified/Registered Engineer & duly authorised of
.....BROWN CONSULTING PTY LTD.....
(Consulting firm or company)

hereby:-

- certify that the information in this drawing is an accurate "as constructed" representation of the works.
- accept responsibility for the 'as constructed' information contained in this drawing
- acknowledge the 'as constructed' information contained in this drawing may be relied on by Council and others.

Certification for stage by on
(stage no.) (signature) (date)
forBROWN CONSULTING PTY LTD.....
(Consulting firm or company)

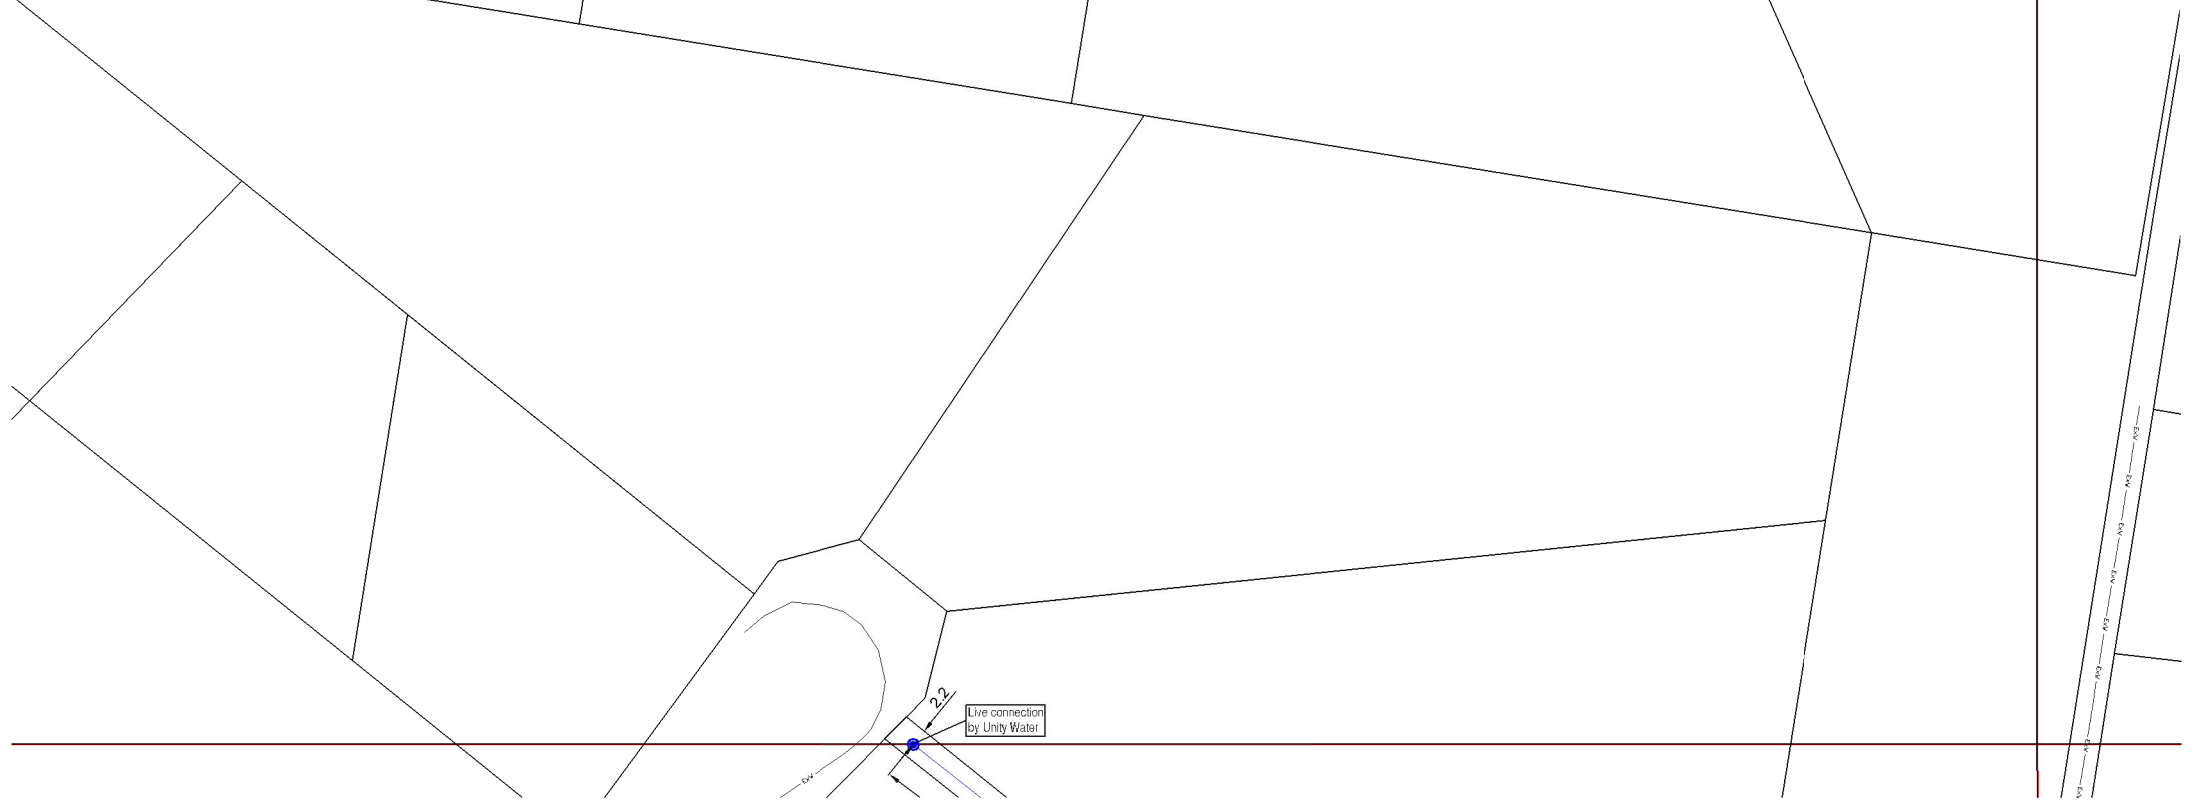

DRAWING REVISIONS		REFERENCE DRAWINGS		DESIGN FILE No.	DESIGNED
REV.	REVISION DESCRIPTION	DRG. No.	DESCRIPTION	CONSTRUCT. No.	DATE
				SURVEY FILE No. S-7433-???	DRAWN JB
				FIELD BOOK	DATE 11/7/14
				LOG BOOK	CHECKED JR
				LEVEL DATUM PH57810 (RL47.338m)	DATE Date
				DATUM MGA Zone 56	


THIS WORK WAS PREPARED BY:
DEFENCE HOUSING AUSTRALIA

SCALE 1:500 ORIGINAL SIZE A1

MORETON BAY REGIONAL COUNCIL
CABOOLTURE DISTRICT OFFICE
2 HASKING STREET CABOOLTURE QLD 4510
PO BOX 159 CABOOLTURE QLD 4510
Telephone: (07) 5433 0100
Fax: (07) 5433 4000

WARNER SPRINGS ESTATE
External Water Main
Jacksonia Drive, Warner
'AS CONSTRUCTED' - WATER

MBRC SUBDIVISION REFERENCE	
Development No.	
No. 1 OF 3 PLANS	
ASCON GRID NUMBER	REV.
51338	

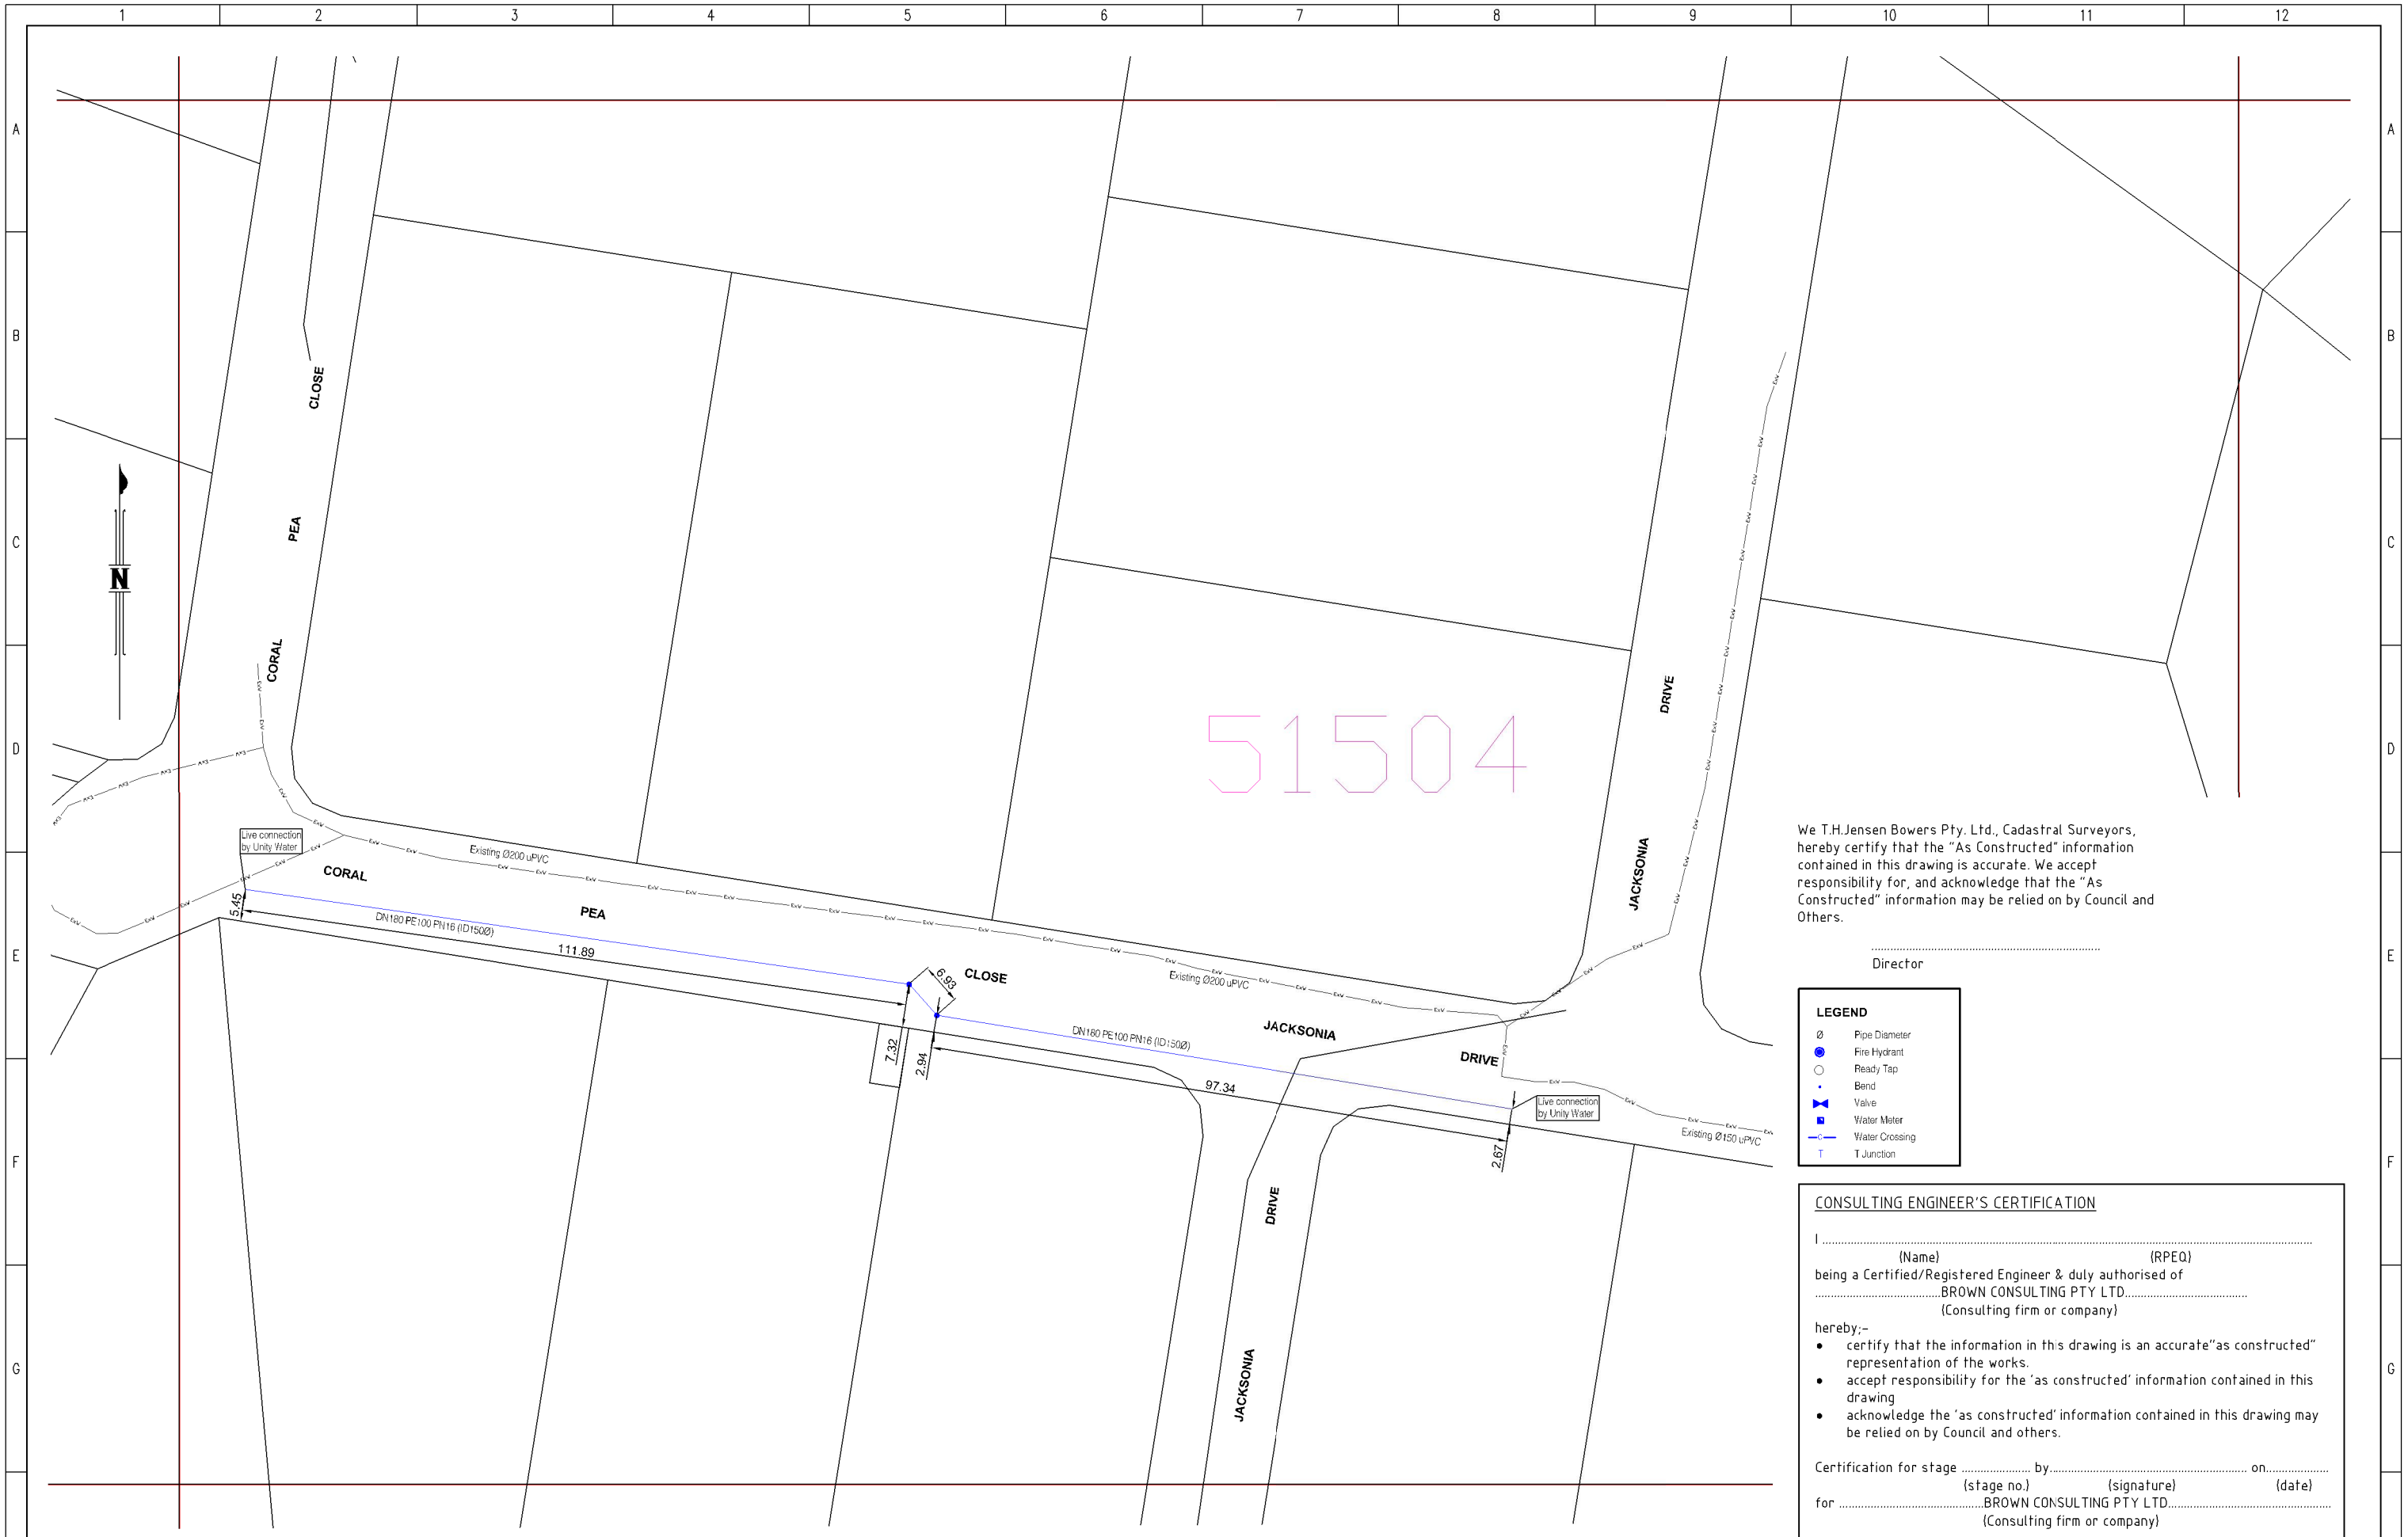

We T.H.Jensen Bowers Pty. Ltd., Cadastral Surveyors, hereby certify that the "As Constructed" information contained in this drawing is accurate. We accept responsibility for, and acknowledge that the "As Constructed" information may be relied on by Council and Others.

.....
Director

LEGEND

- Ø Pipe Diameter
- Fire Hydrant
- Ready Tap
- Bend
- ⊕ Valve
- Water Meter
- Water Crossing
- T T Junction

CONSULTING ENGINEER'S CERTIFICATION

I
(Name) (RPEQ)
being a Certified/Registered Engineer & duly authorised of
.....BROWN CONSULTING PTY LTD.....
(Consulting firm or company)

hereby;-


- certify that the information in this drawing is an accurate "as constructed" representation of the works.
- accept responsibility for the 'as constructed' information contained in this drawing
- acknowledge the 'as constructed' information contained in this drawing may be relied on by Council and others.

Certification for stage by on
(stage no.) (signature) (date)
forBROWN CONSULTING PTY LTD.....
(Consulting firm or company)

DRAWING REVISIONS		REFERENCE DRAWINGS		DESIGN FILE No.	DESIGNED
REV.	REVISION DESCRIPTION	DRG. No.	DESCRIPTION	CONSTRUCT. No.	DATE
				SURVEY FILE No. S-7433-???	DRAWN JB
				LOG BOOK	DATE 11/7/14
				LEVEL DATUM PH57810 (RL47.338m)	CHECKED JR
				DATUM MGA Zone 56	DATE Date

THIS WORK WAS PREPARED BY:
DEFENCE HOUSING AUSTRALIA

SCALE 1:500 ORIGINAL SIZE A1



MORETON BAY REGIONAL COUNCIL
CABOOLTURE DISTRICT OFFICE
2 HASKING STREET CABOOLTURE QLD 4510
PO BOX 159 CABOOLTURE QLD 4510
Telephone: (07) 5433 0100
Fax: (07) 5433 4000

WARNER SPRINGS ESTATE
External Water Main
Jacksonia Drive, Warner
'AS CONSTRUCTED' - WATER

MBC SUBDIVISION REFERENCE

Development No.	
No. 2 OF 3 PLANS	
ASCON GRID NUMBER	REV.
51504	

